

# AS-BUILT DOCUMENTATION

**5555 CLEVELAND AVENUE  
COLUMBUS, OHIO 43231**



**100% SUBMITTAL**

## DRAWING INDEX

- C-1 COVER SHEET | DRAWING INDEX
- AB-1 FLOOR PLAN
- AB-2 EXTERIOR ELEVATIONS
- AB-3 MEP / RCP / PHOTO KEY MAP
- AB-4 ROOF PLAN
- AB-5 BUILDING SECTIONS
- AB-6 BUILDING SECTIONS
- AB-7 ENLARGED SECTION "A"
- AB-8 ENLARGED SECTION "B"
- AB-9 ENLARGED SECTION "C"
- AB-10 ENLARGED SECTION "D"



VICINITY MAP  
NTS

**AS BUILT**  
PROFESSIONALS

A DIVISION OF:



©2016 AEC CONSULTANTS, INC.

**ARCHITECTURAL AS BUILT  
COMMERCIAL FACILITY DOCUMENTATION  
5555 CLEVELAND AVENUE  
COLUMBUS, OHIO**

01 100% SUBMISSION 09-02-16

NO. ISSUES | REVISIONS DATE

SHEET TITLE

**COVER  
SHEET**

HL PROJECT MANAGER

HL PROJECT DIRECTOR

9-2-16-1 PROJECT NUMBER

AS NOTED SCALE


CL DRAWN BY

SHEET NUMBER


**C-1**




**ARCHITECTURAL AS BUILT**  
**COMMERCIAL FACILITY DOCUMENTATION**  
**5555 CLEVELAND AVENUE**  
**COLUMBUS, OHIO**

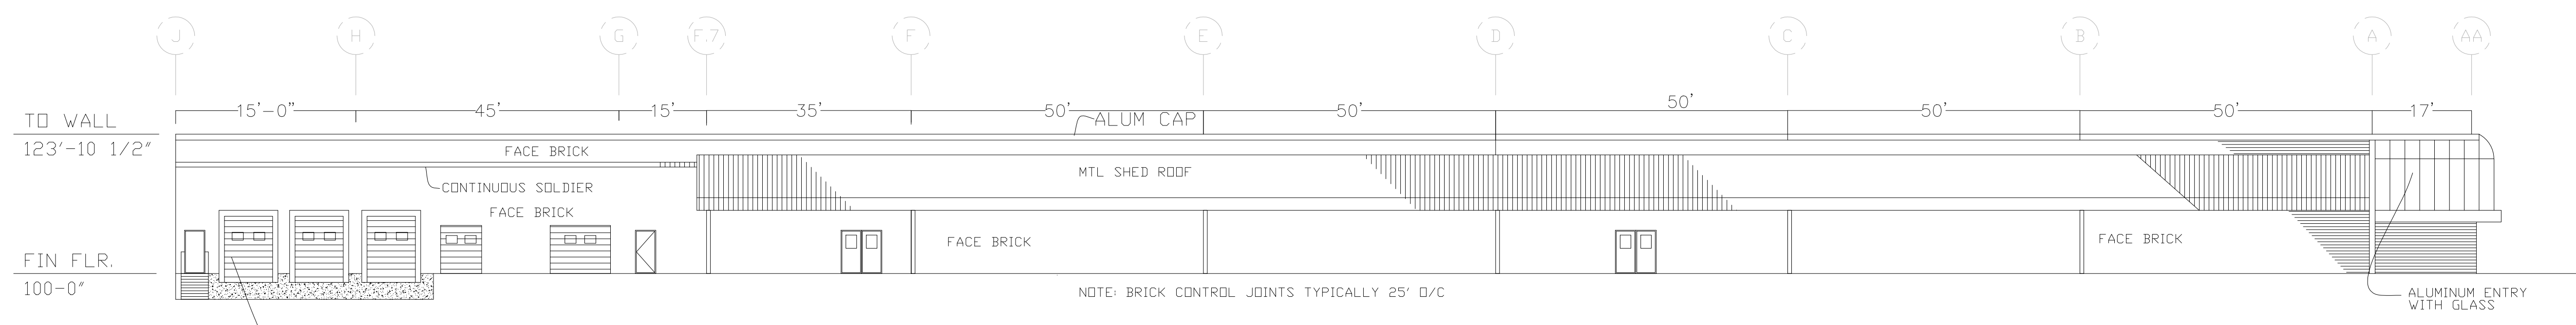



① BUILDING ELEVATION - LEFT SIDE  
SCALE: 1/16" = 1'-0"

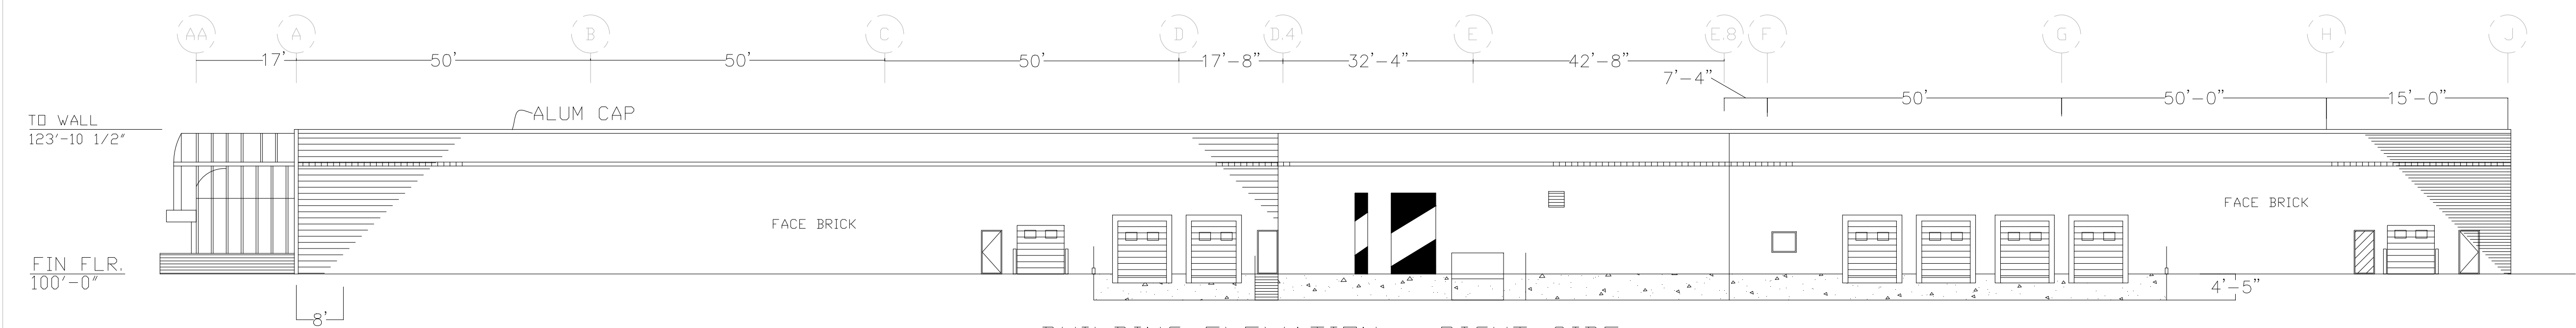


② BUILDING ELEVATION - RIGHT SIDE  
SCALE: 1/16" = 1'-0"

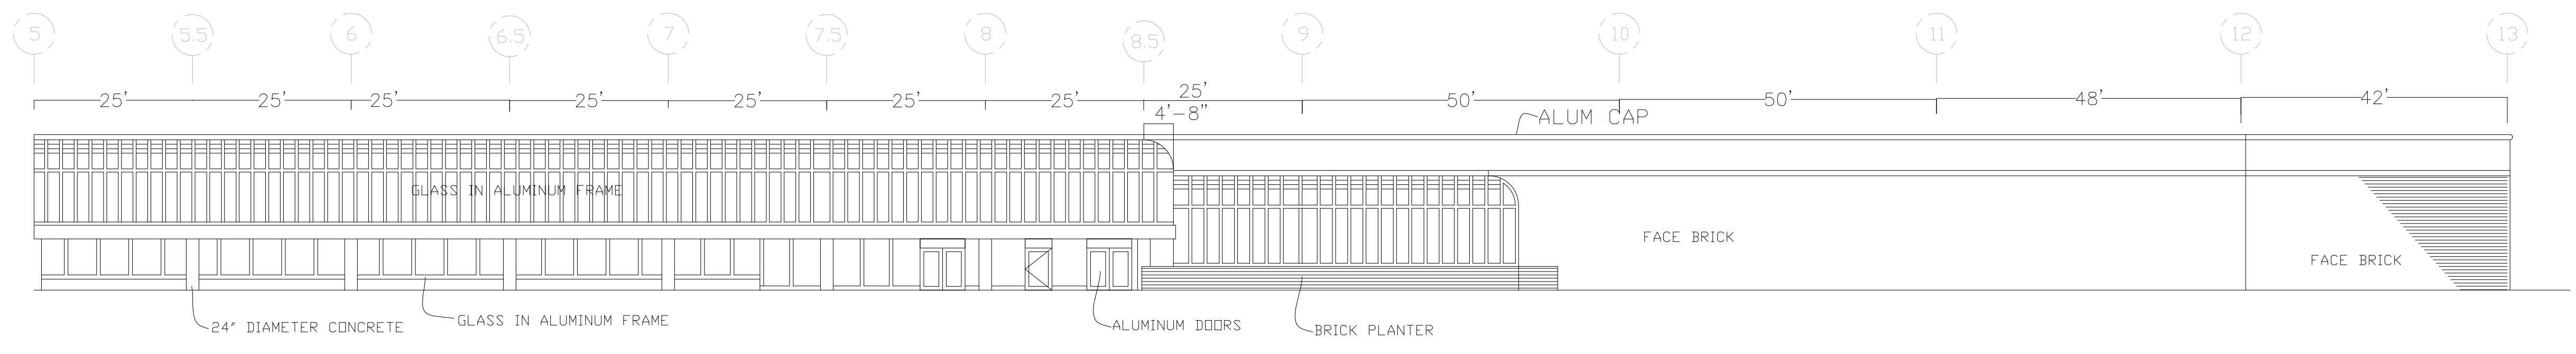


③ PARTIAL BUILDING ELEVATION - FRONT  
SCALE: 1/16" = 1'-0"

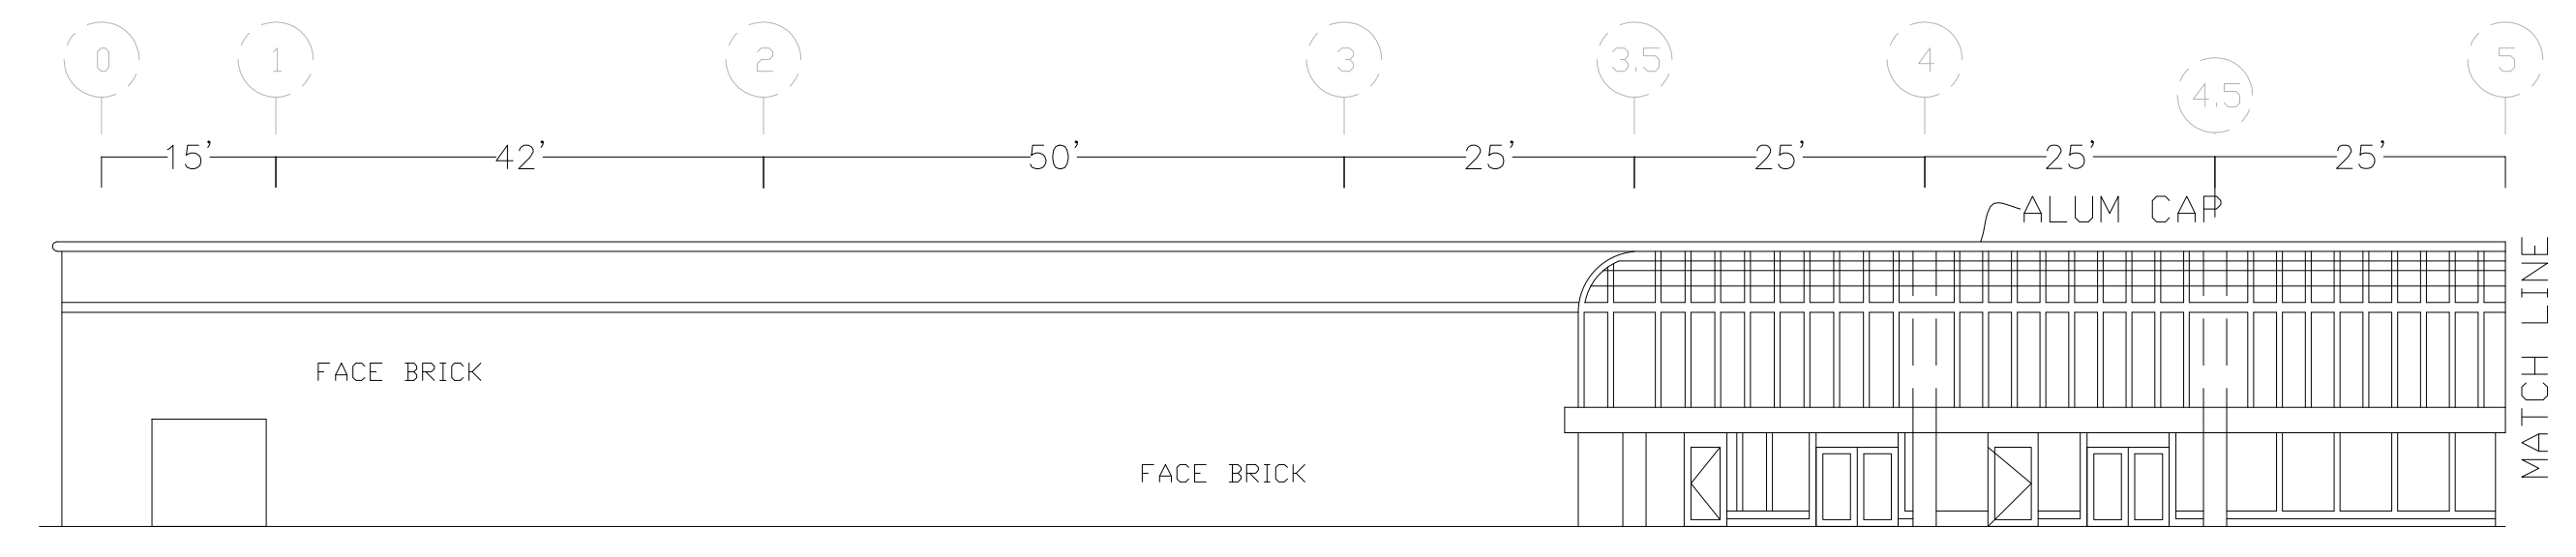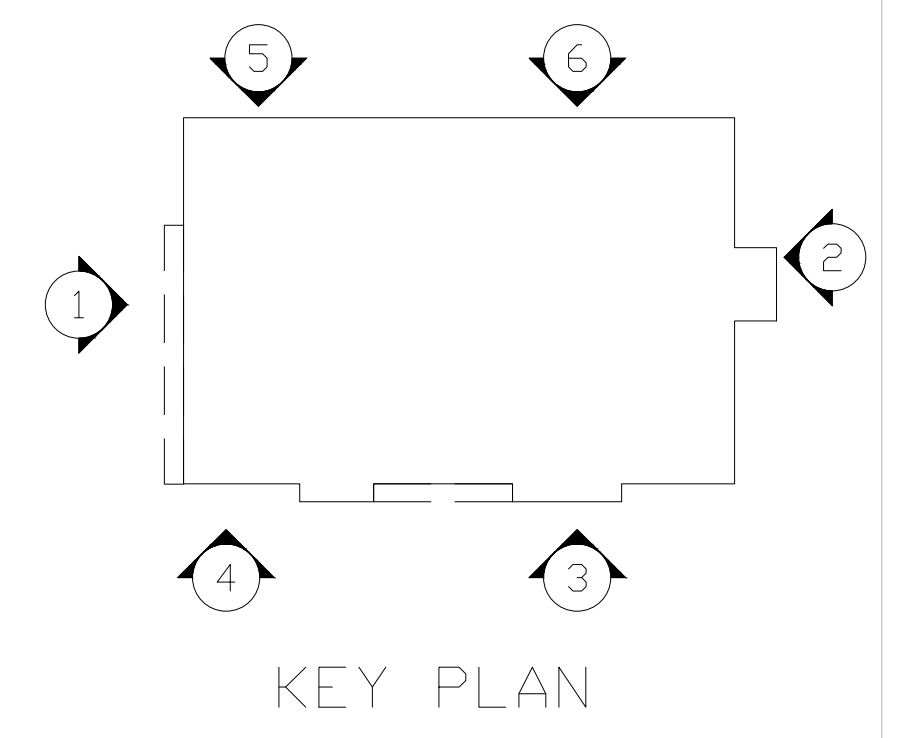

④ PARTIAL BUILDING ELEVATION - FRONT  
SCALE: 1/16" = 1'-0"

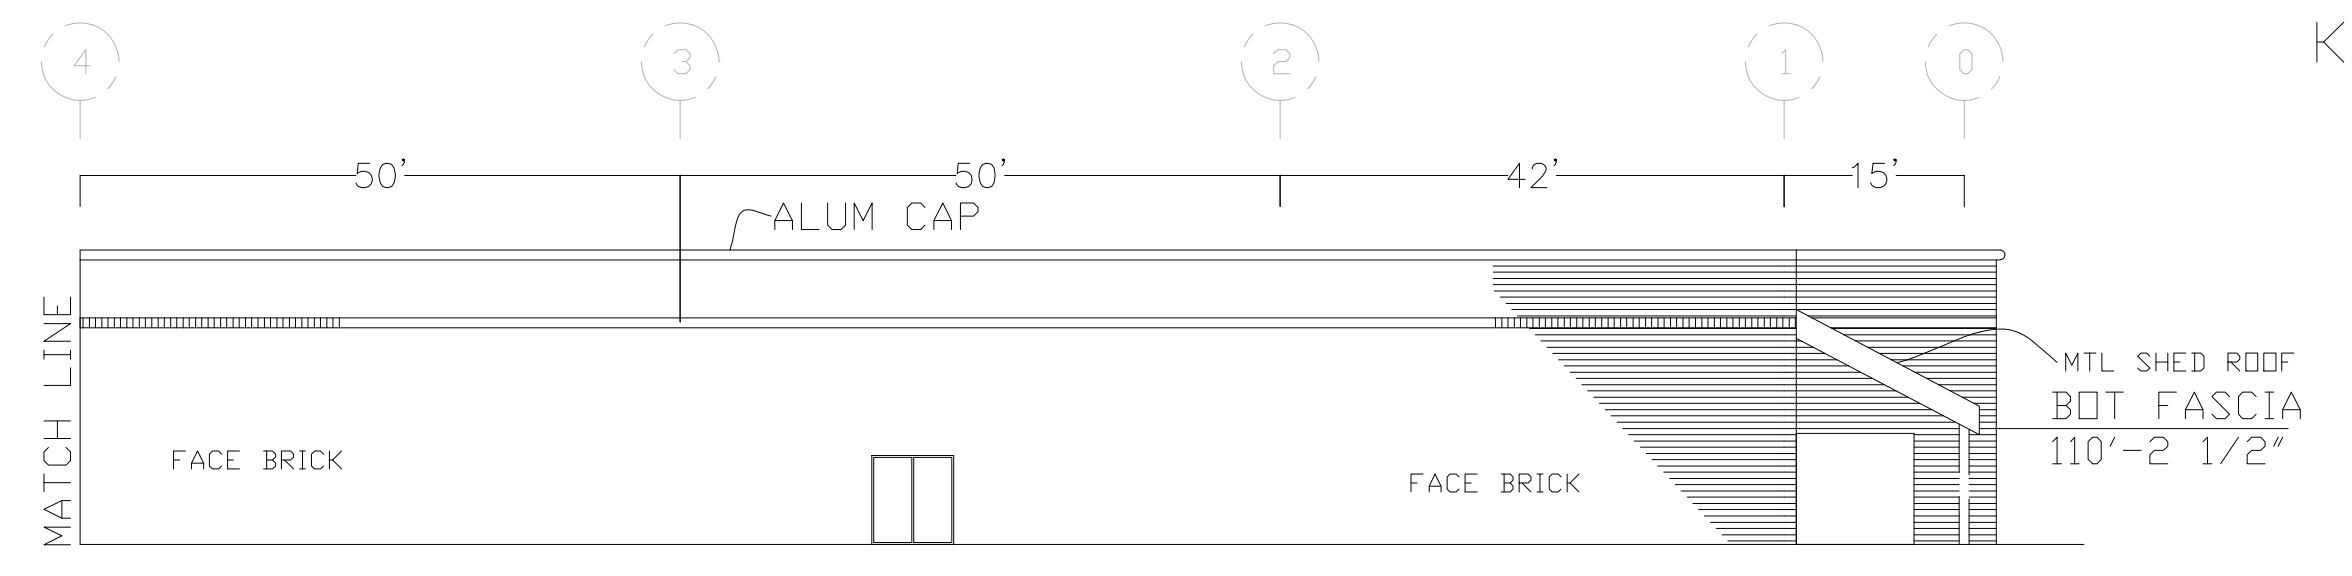

⑤ PARTIAL BUILDING ELEVATION - REAR  
SCALE: 1/16" = 1'-0"

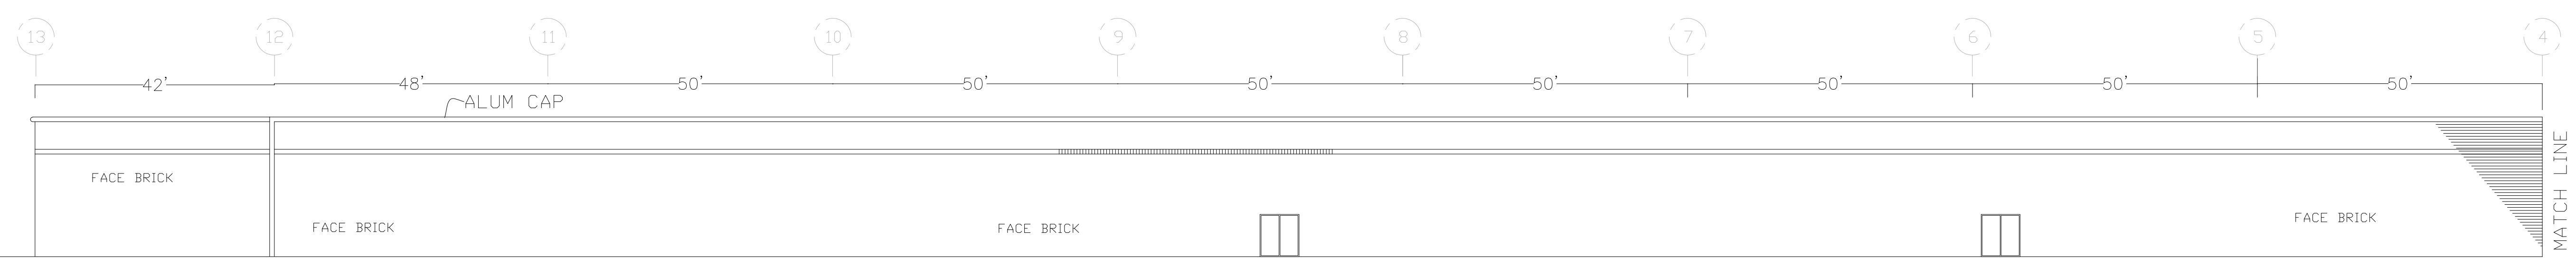

⑥ PARTIAL BUILDING ELEVATION - REAR  
SCALE: 1/16" = 1'-0"

NO.	ISSUES   REVISIONS	DATE	SHEET TITLE
01	100% SUBMISSION		

EXTERIOR ELEVATIONS	
HL	PROJECT MANAGER
HL	PROJECT DIRECTOR
9-2-16-1	PROJECT NUMBER
AS NOTED	SCALE
CL	DRAWN BY
	SHEET NUMBER



**ARCHITECTURAL AS BUILT**  
COMMERCIAL FACILITY DOCUMENTATION  
5555 CLEVELAND AVENUE  
**COLUMBUS, OHIO**

**PHOTO DOCUMENTATION LEGEND**


INDICATES LOCATION OF CAMERA  
INDICATES DIRECTION OF CAMERA LENS AND CORRESPONDING PHOTO / VIDEO NUMBER

**TYPES OF DOCUMENTATION**


	GROUND BASED PHOTO		GROUND BASED VIDEO		360° SPHERICAL PHOTO		AERIAL BASED PHOTO		AERIAL BASED VIDEO
--	--------------------	--	--------------------	--	----------------------	--	--------------------	--	--------------------

**SYMBOLS LEGEND**

<b>RCP</b>	<b>ELECTRIC</b>
	DATA OUTLET
	TELEPHONE JACK
	ELECTRIC SWITCH
	CABLE TELEVISION OUTLET
	SWITCH RECEPTACLE
	INDUSTRIAL ELECTRIC CONNECTION OF OUTLET
	DIFFERENTIAL SWITCH
	ALARM BELL
	ALARM BELL SILENCER
	ALARM BELL SILENCER
	ELECTRIC PANEL
	ELECTRIC METER
	BUTTON SWITCH
	EMERGENCY SWITCH
	GROUND/FLOOR LIGHT
	KEY PAD
	<b>FIRE PROTECTION</b>
	FIRE EXTINGUISHER
	FIRE PULL
	FIRE ALARM (HORN/STROBE)
	SMOKE DETECTOR
	SPRINKLER HEAD
	<b>MEP</b>
	THERMOSTAT
	FLOOR DRAIN
	VALVE
	WATER SUPPLY
	SUSPENDED GAS HEATER
	<b>MISC</b>
	ROLLARD

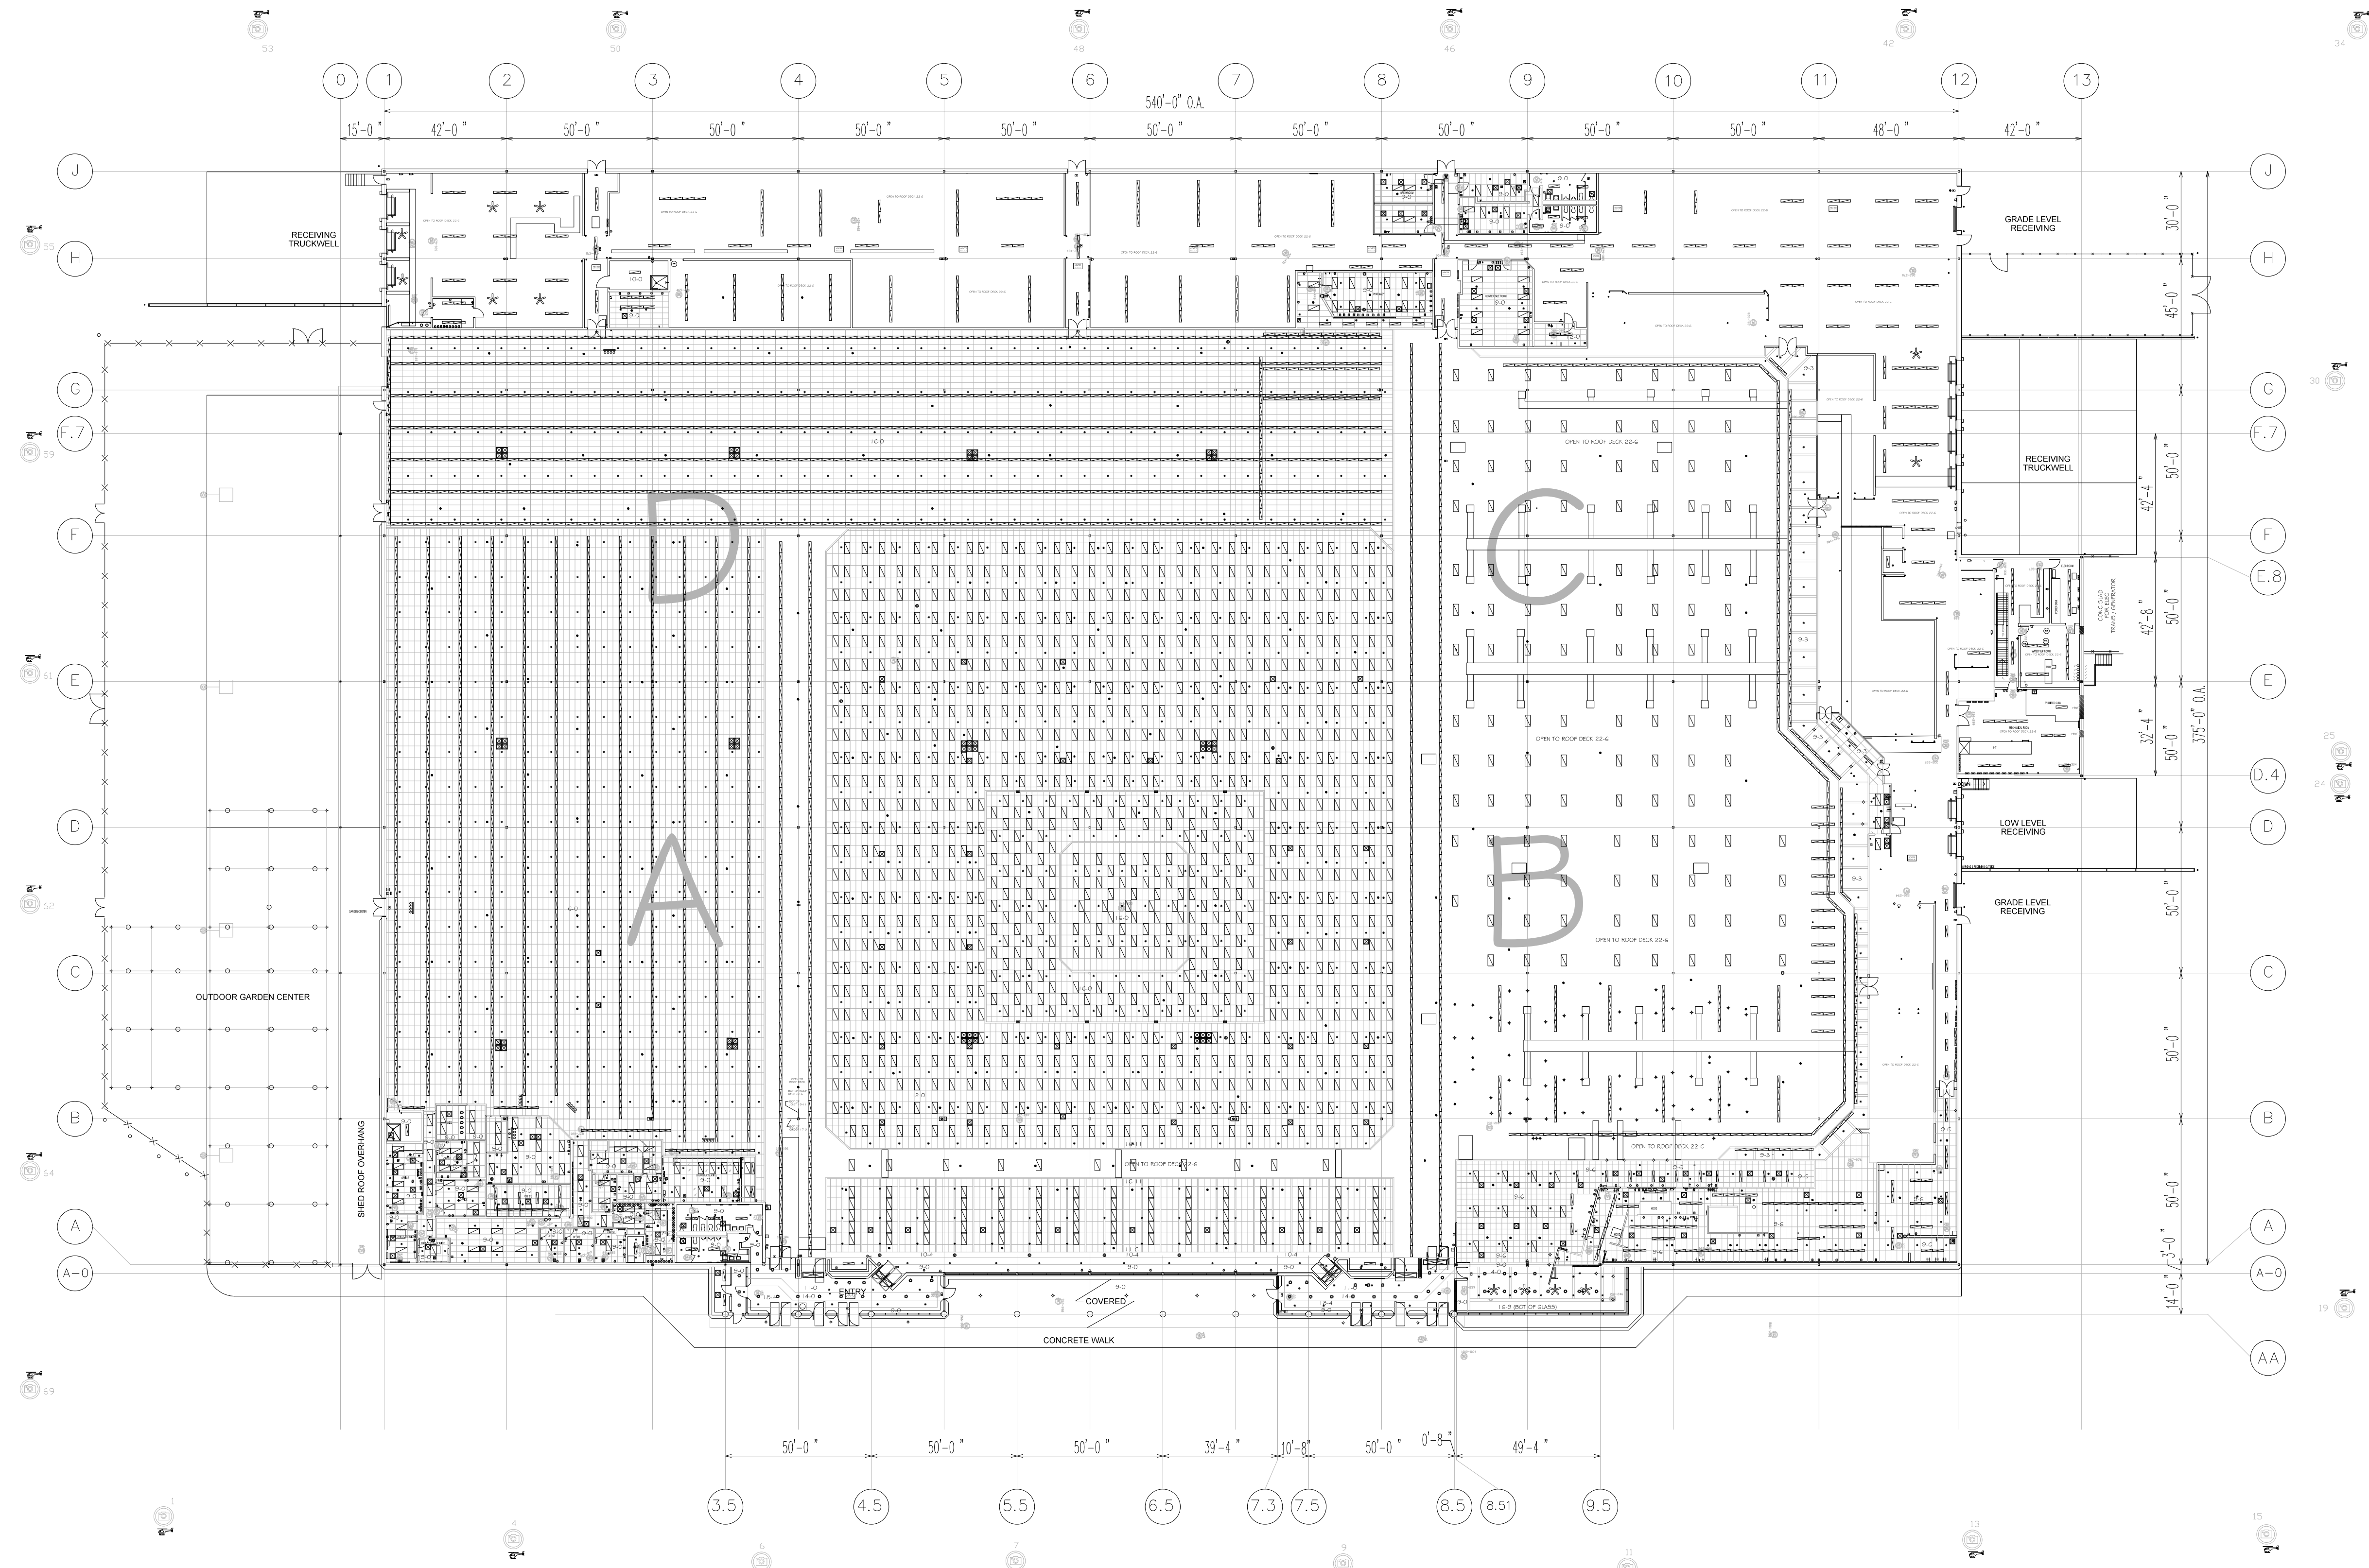

FLOOR PLAN  $\frac{1}{32}'' = 1'-0''$

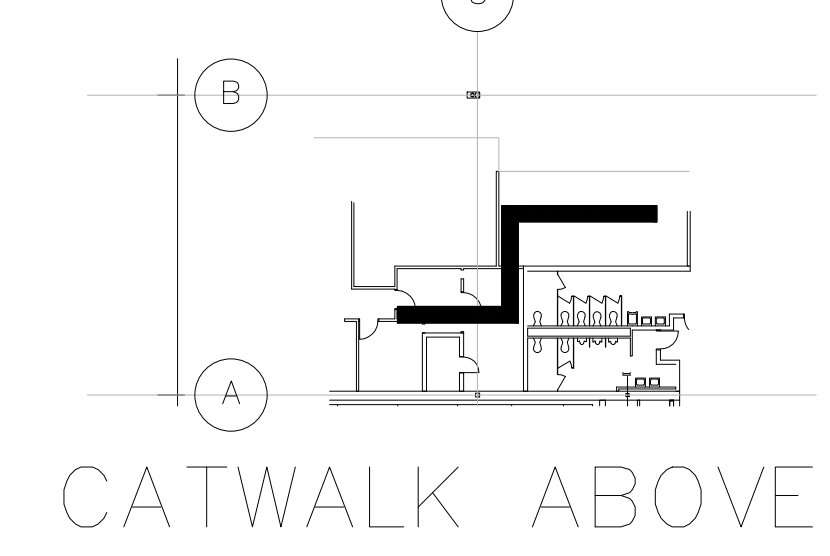


01	100% SUBMISSION	
NO.	ISSUES   REVISIONS	DATE
		SHEET TITLE

**MEP / RCP / PHOTO**

HL	PROJECT MANAGER
HL	PROJECT DIRECTOR
9-2-16-1	PROJECT NUMBER
AS NOTED	SCALE
CL	DRAWN BY
	SHEET NUMBER


**AB-3**

**ARCHITECTURAL AS BUILT**  
**COMMERCIAL FACILITY DOCUMENTATION**  
**5555 CLEVELAND AVENUE**  
**COLUMBUS, OHIO**

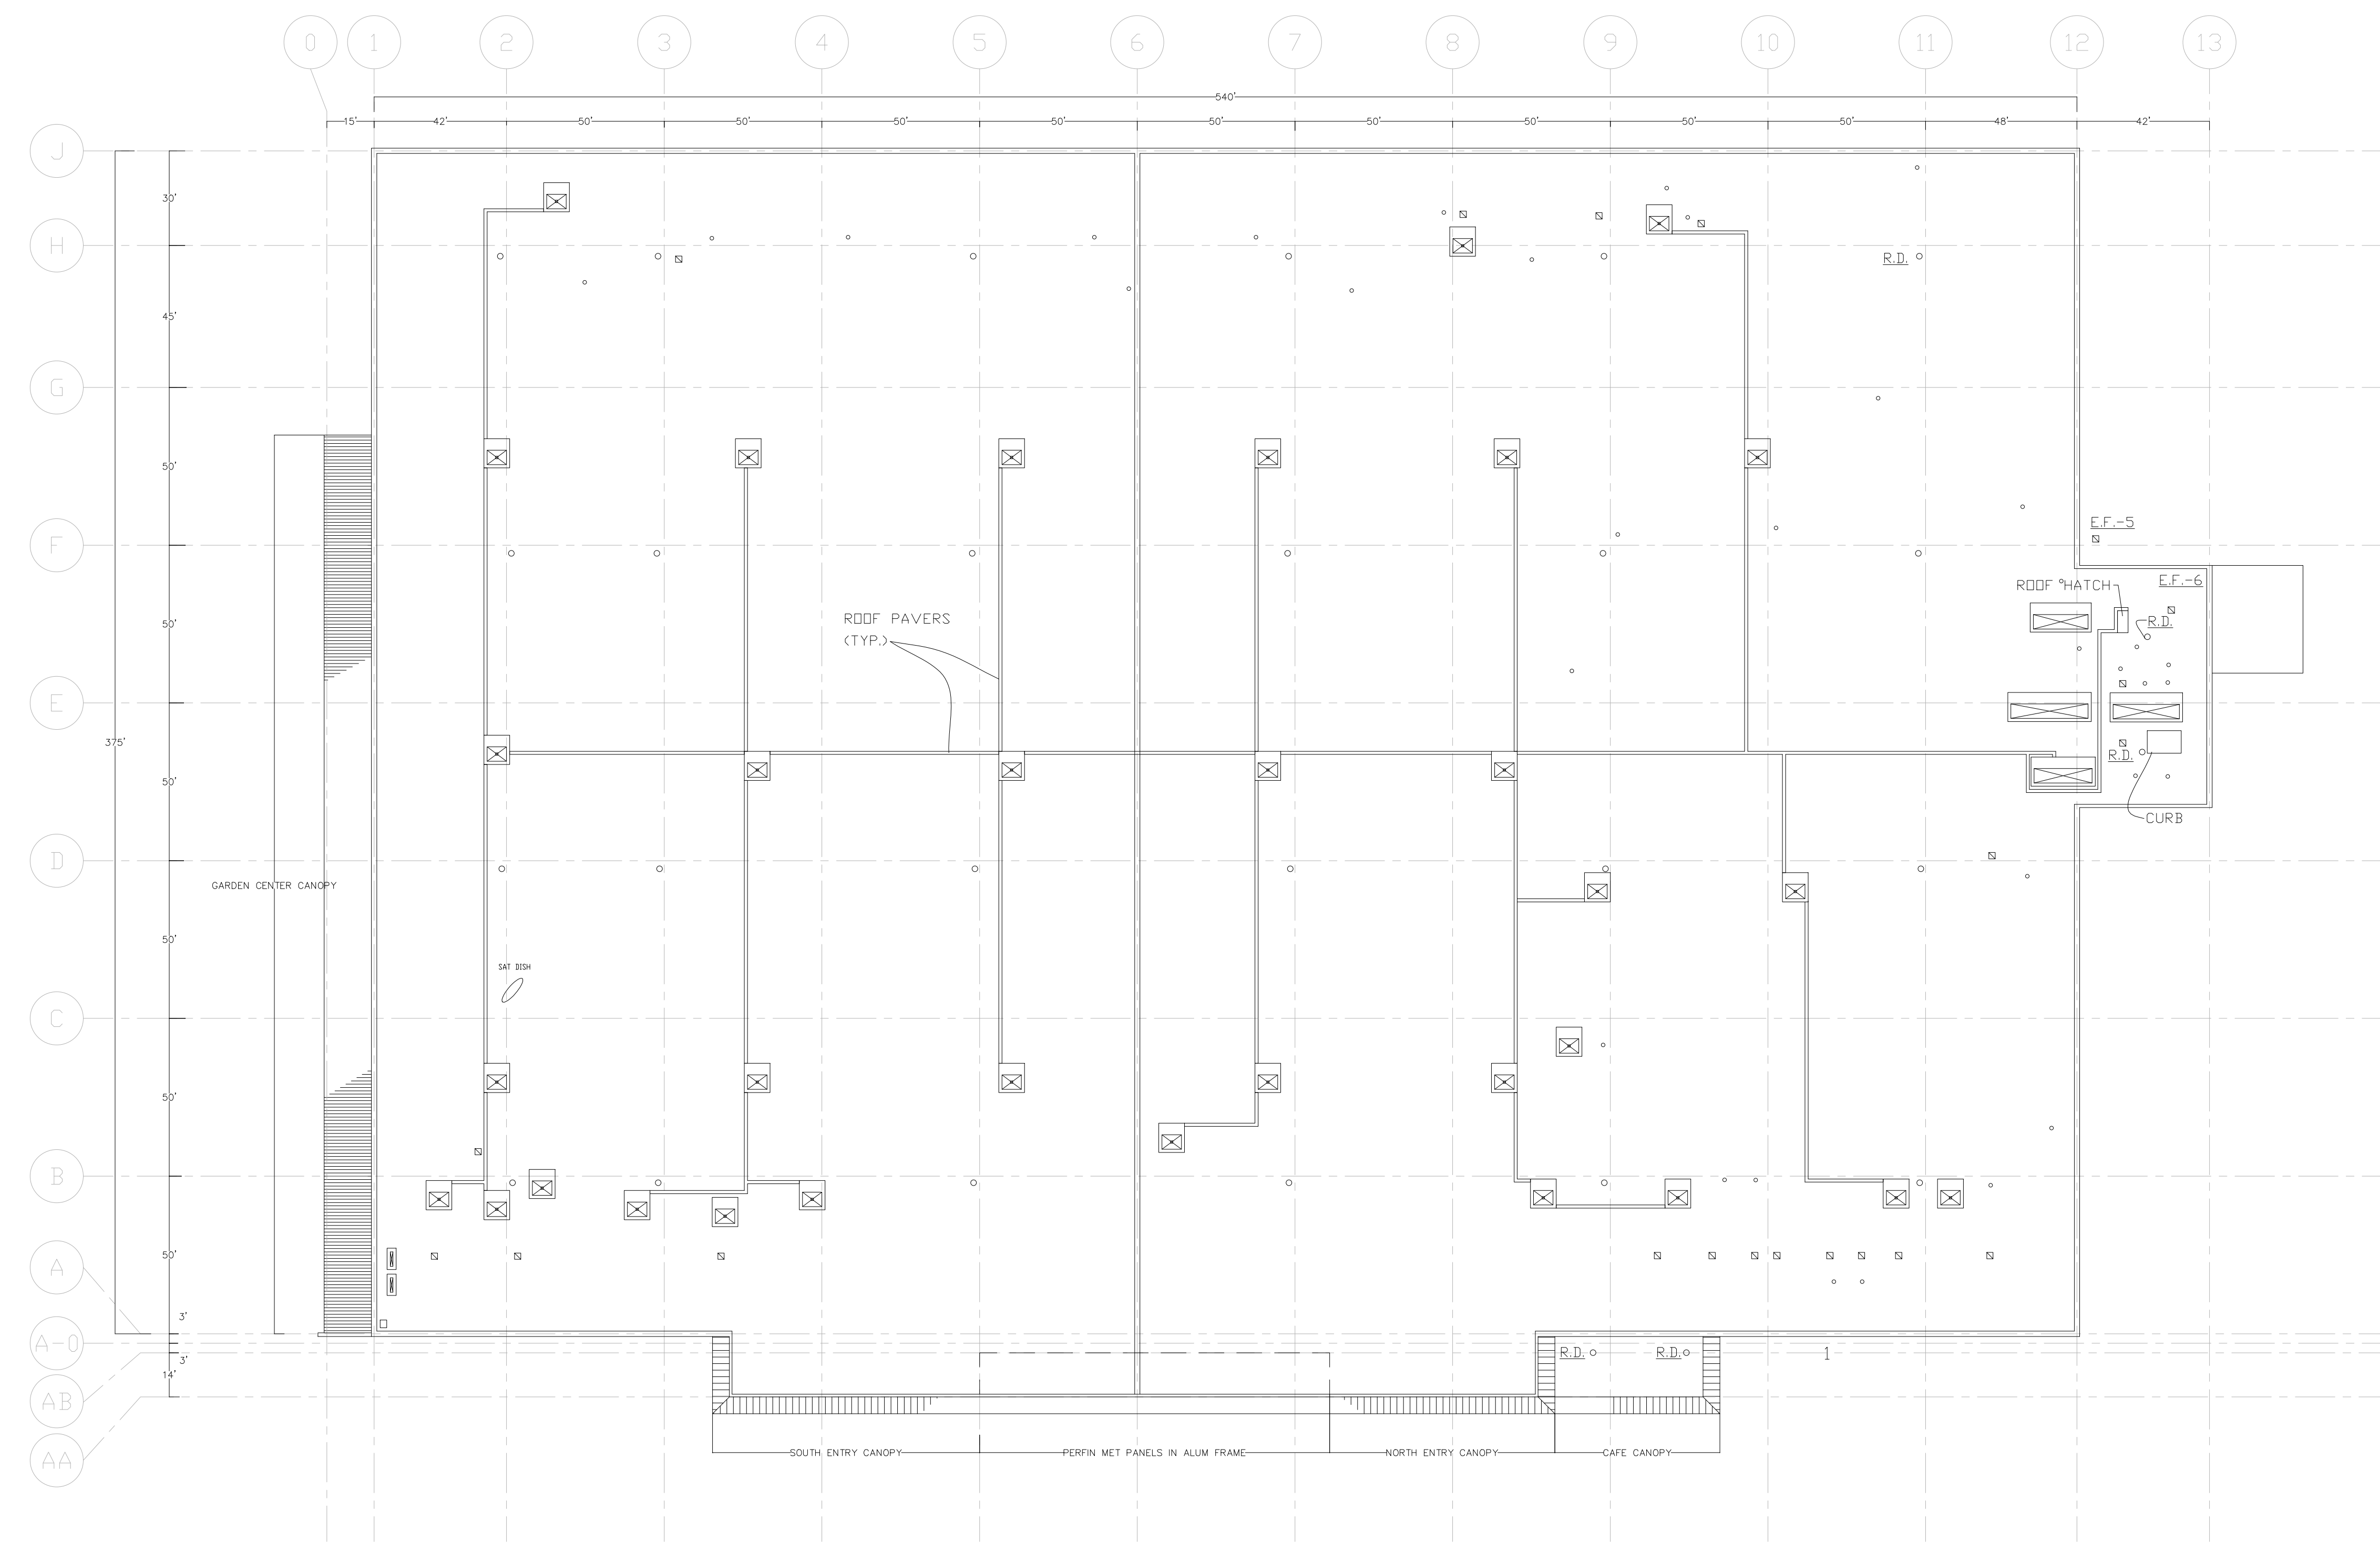


- LEGEND :**
- R.D. - ROOF DRAIN
  - ⊠ E.F. - EXHAUST FAN
  - VT - VENT
  - ⊠ R.T.U. - ROOF TOP UNIT

**OVERALL ROOF PLAN**  
1/32" = 1'-0"

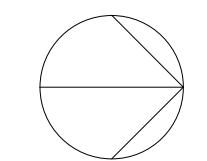


01	100% SUBMISSION	
NO.	ISSUES   REVISIONS	DATE
SHEET TITLE		
<b>ROOF PLAN</b>		
HL	PROJECT MANAGER	
HL	PROJECT DIRECTOR	
9-2-16-1	PROJECT NUMBER	
AS NOTED	SCALE	
CL	DRAWN BY	
	SHEET NUMBER	


**AB-4**

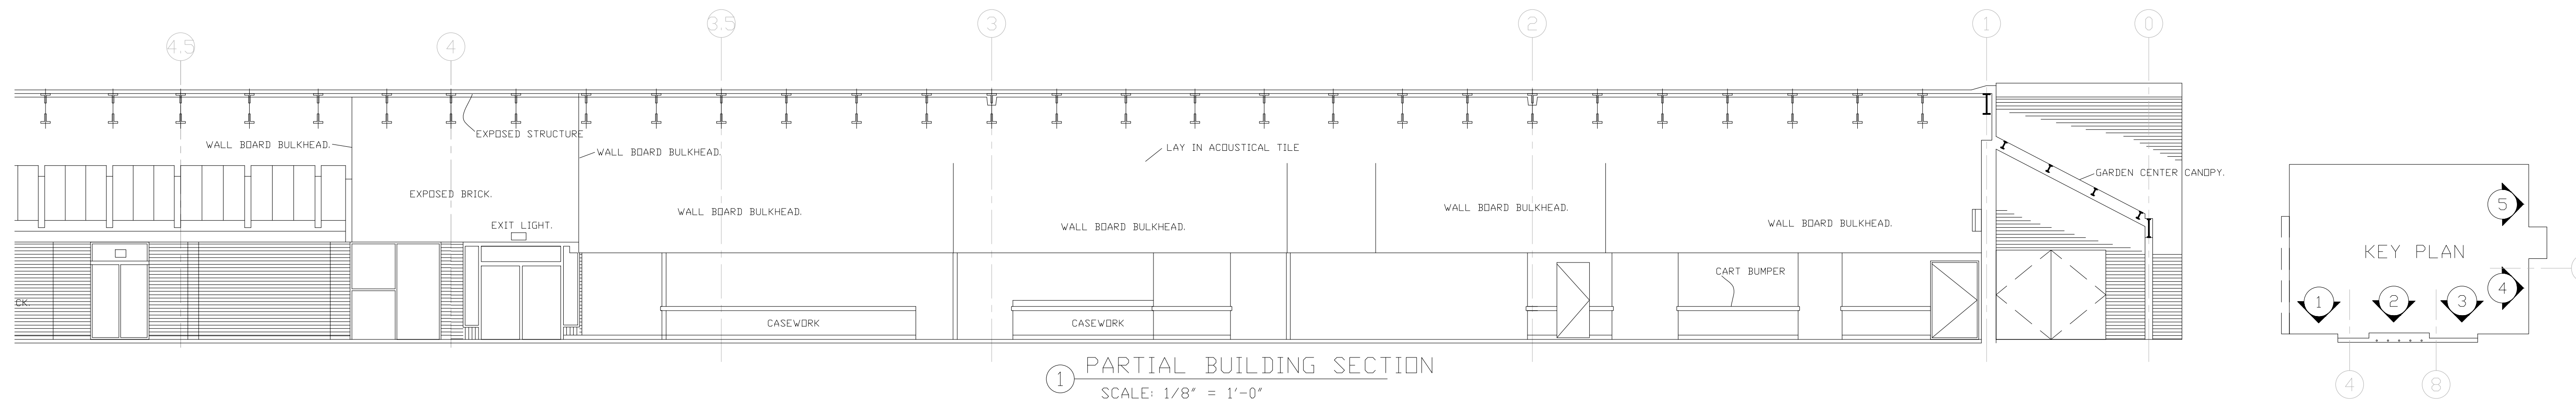


1 PARTIAL BUILDING SECTION  
SCALE: 1/8" = 1'-0"

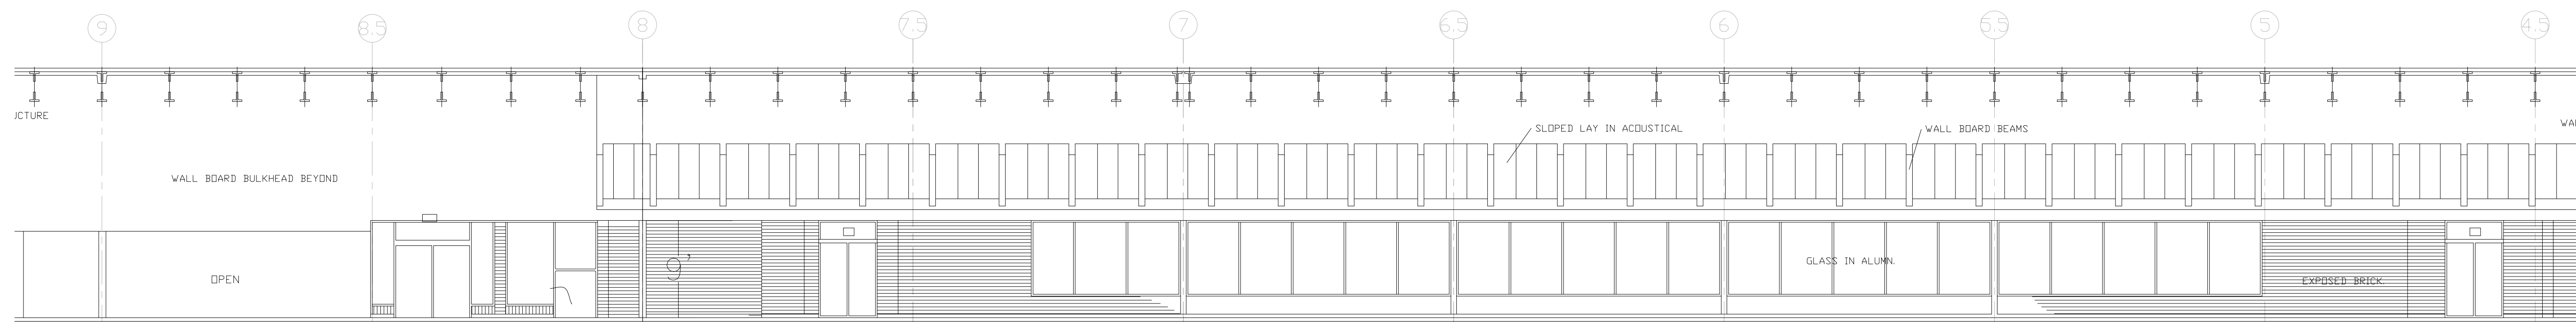


2 PARTIAL BUILDING SECTION  
SCALE: 1/8" = 1'-0"

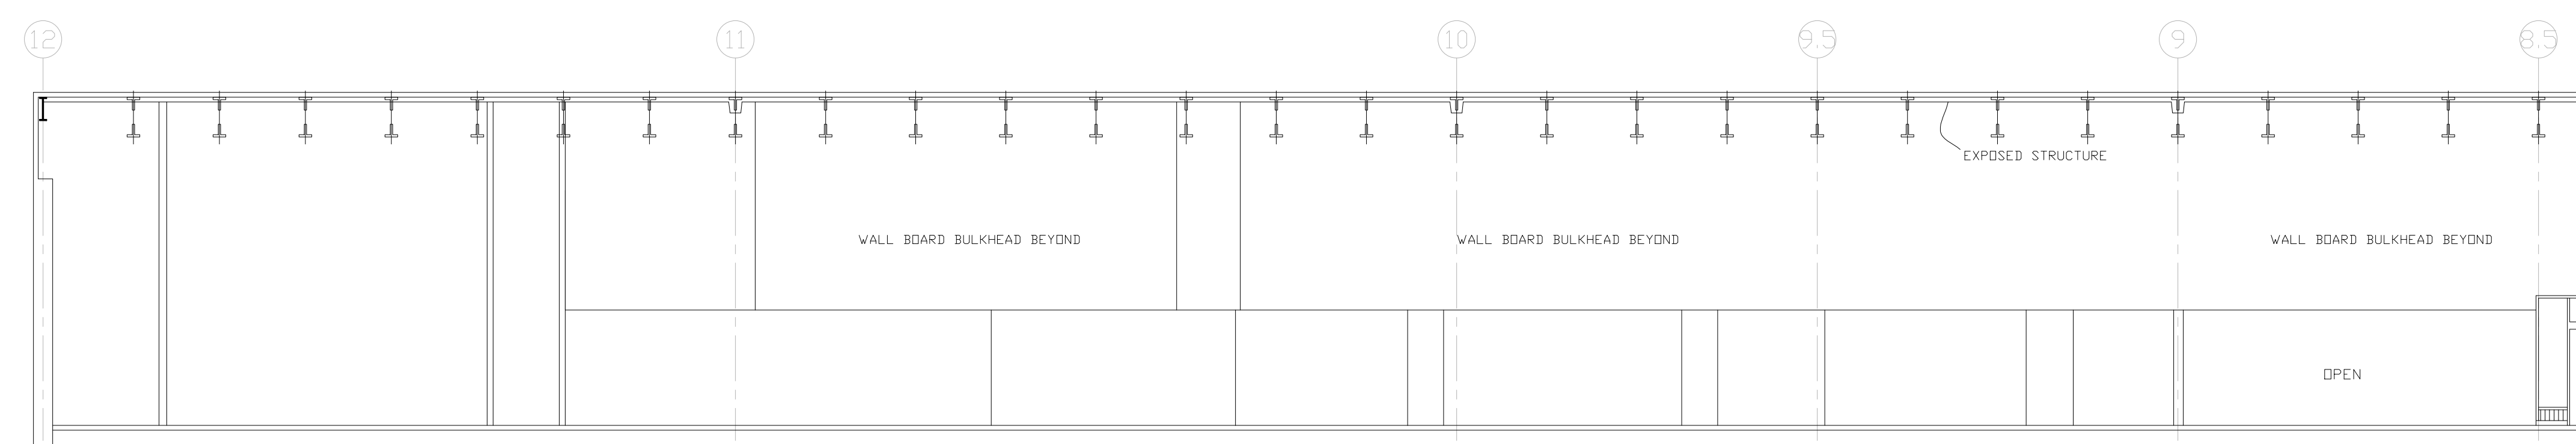

3 PARTIAL BUILDING SECTION  
SCALE: 1/8" = 1'-0"

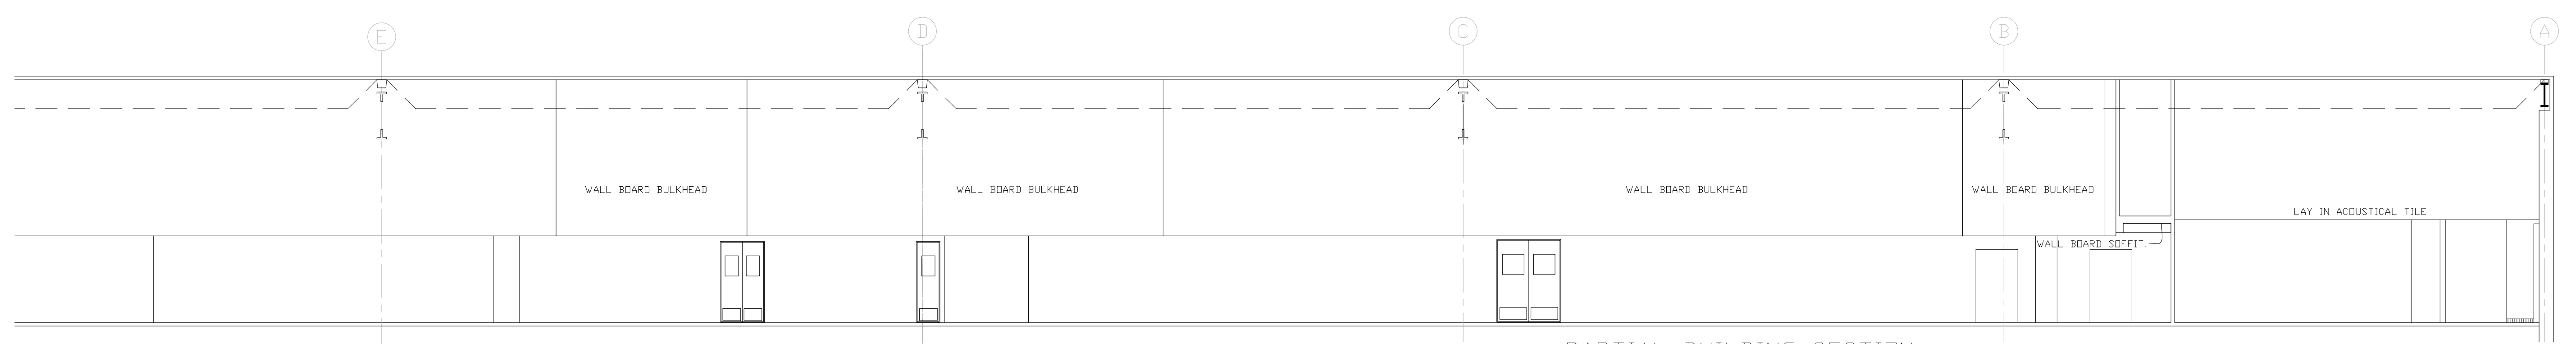

4 PARTIAL BUILDING SECTION

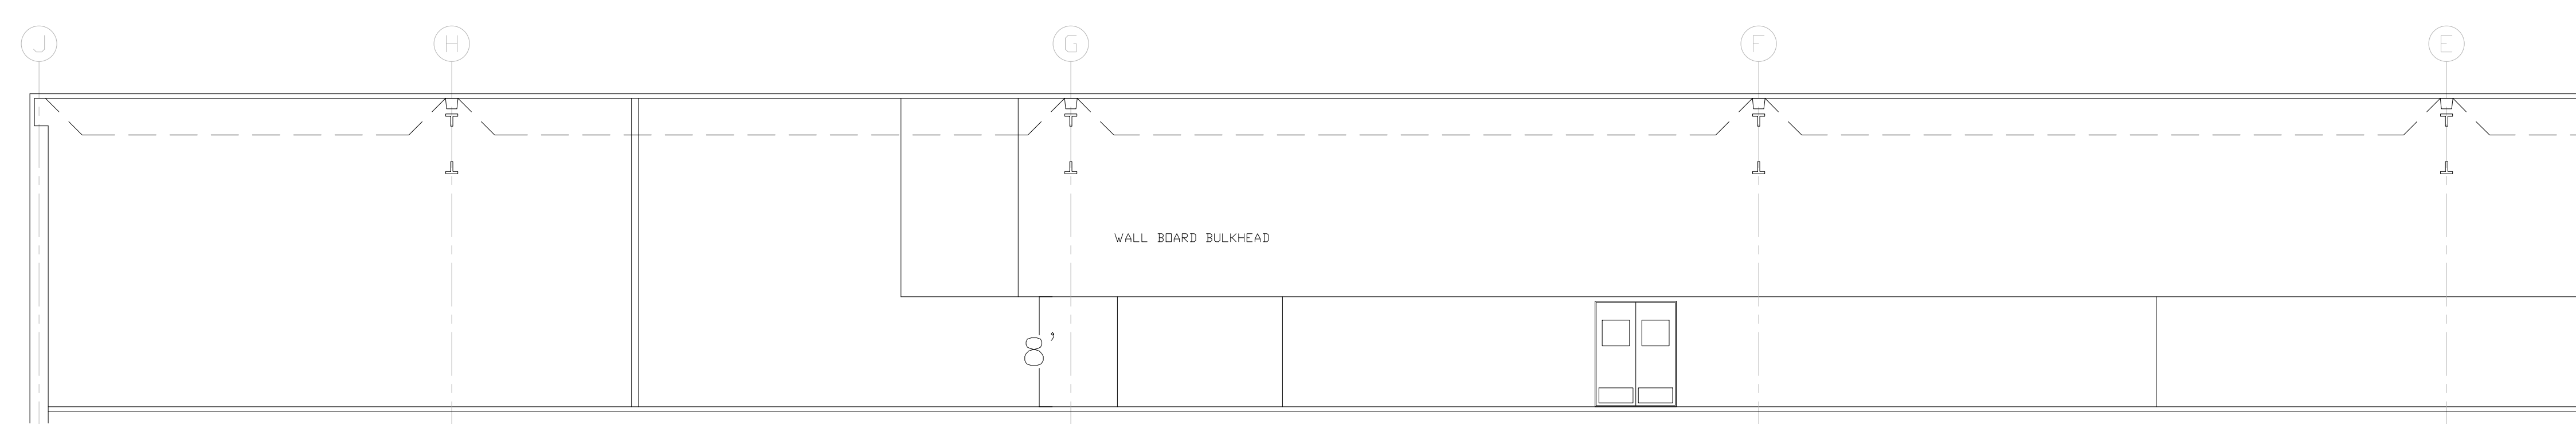

5 PARTIAL BUILDING SECTION  
SCALE: 1/8" = 1'-0"

**AS BUILT**  
PROFESSIONALS  
A DIVISION OF:

**AEC**  
CONSULTANTS INC  
www.aecconsultantsinc.com  
844.272.8458

**ARCHITECTURAL AS BUILT**  
COMMERCIAL FACILITY DOCUMENTATION  
5555 CLEVELAND AVENUE  
**COLUMBUS, OHIO**



01	100% SUBMISSION	
NO.	ISSUES   REVISIONS	DATE
		SHEET TITLE

**BUILDING SECTIONS**

HL	PROJECT MANAGER
HL	PROJECT DIRECTOR
9-2-16-1	PROJECT NUMBER
AS NOTED	SCALE
CL	DRAWN BY
	SHEET NUMBER

**AB-5**


**ARCHITECTURAL AS BUILT**  
**COMMERCIAL FACILITY DOCUMENTATION**  
**5555 CLEVELAND AVENUE**  
**COLUMBUS, OHIO**

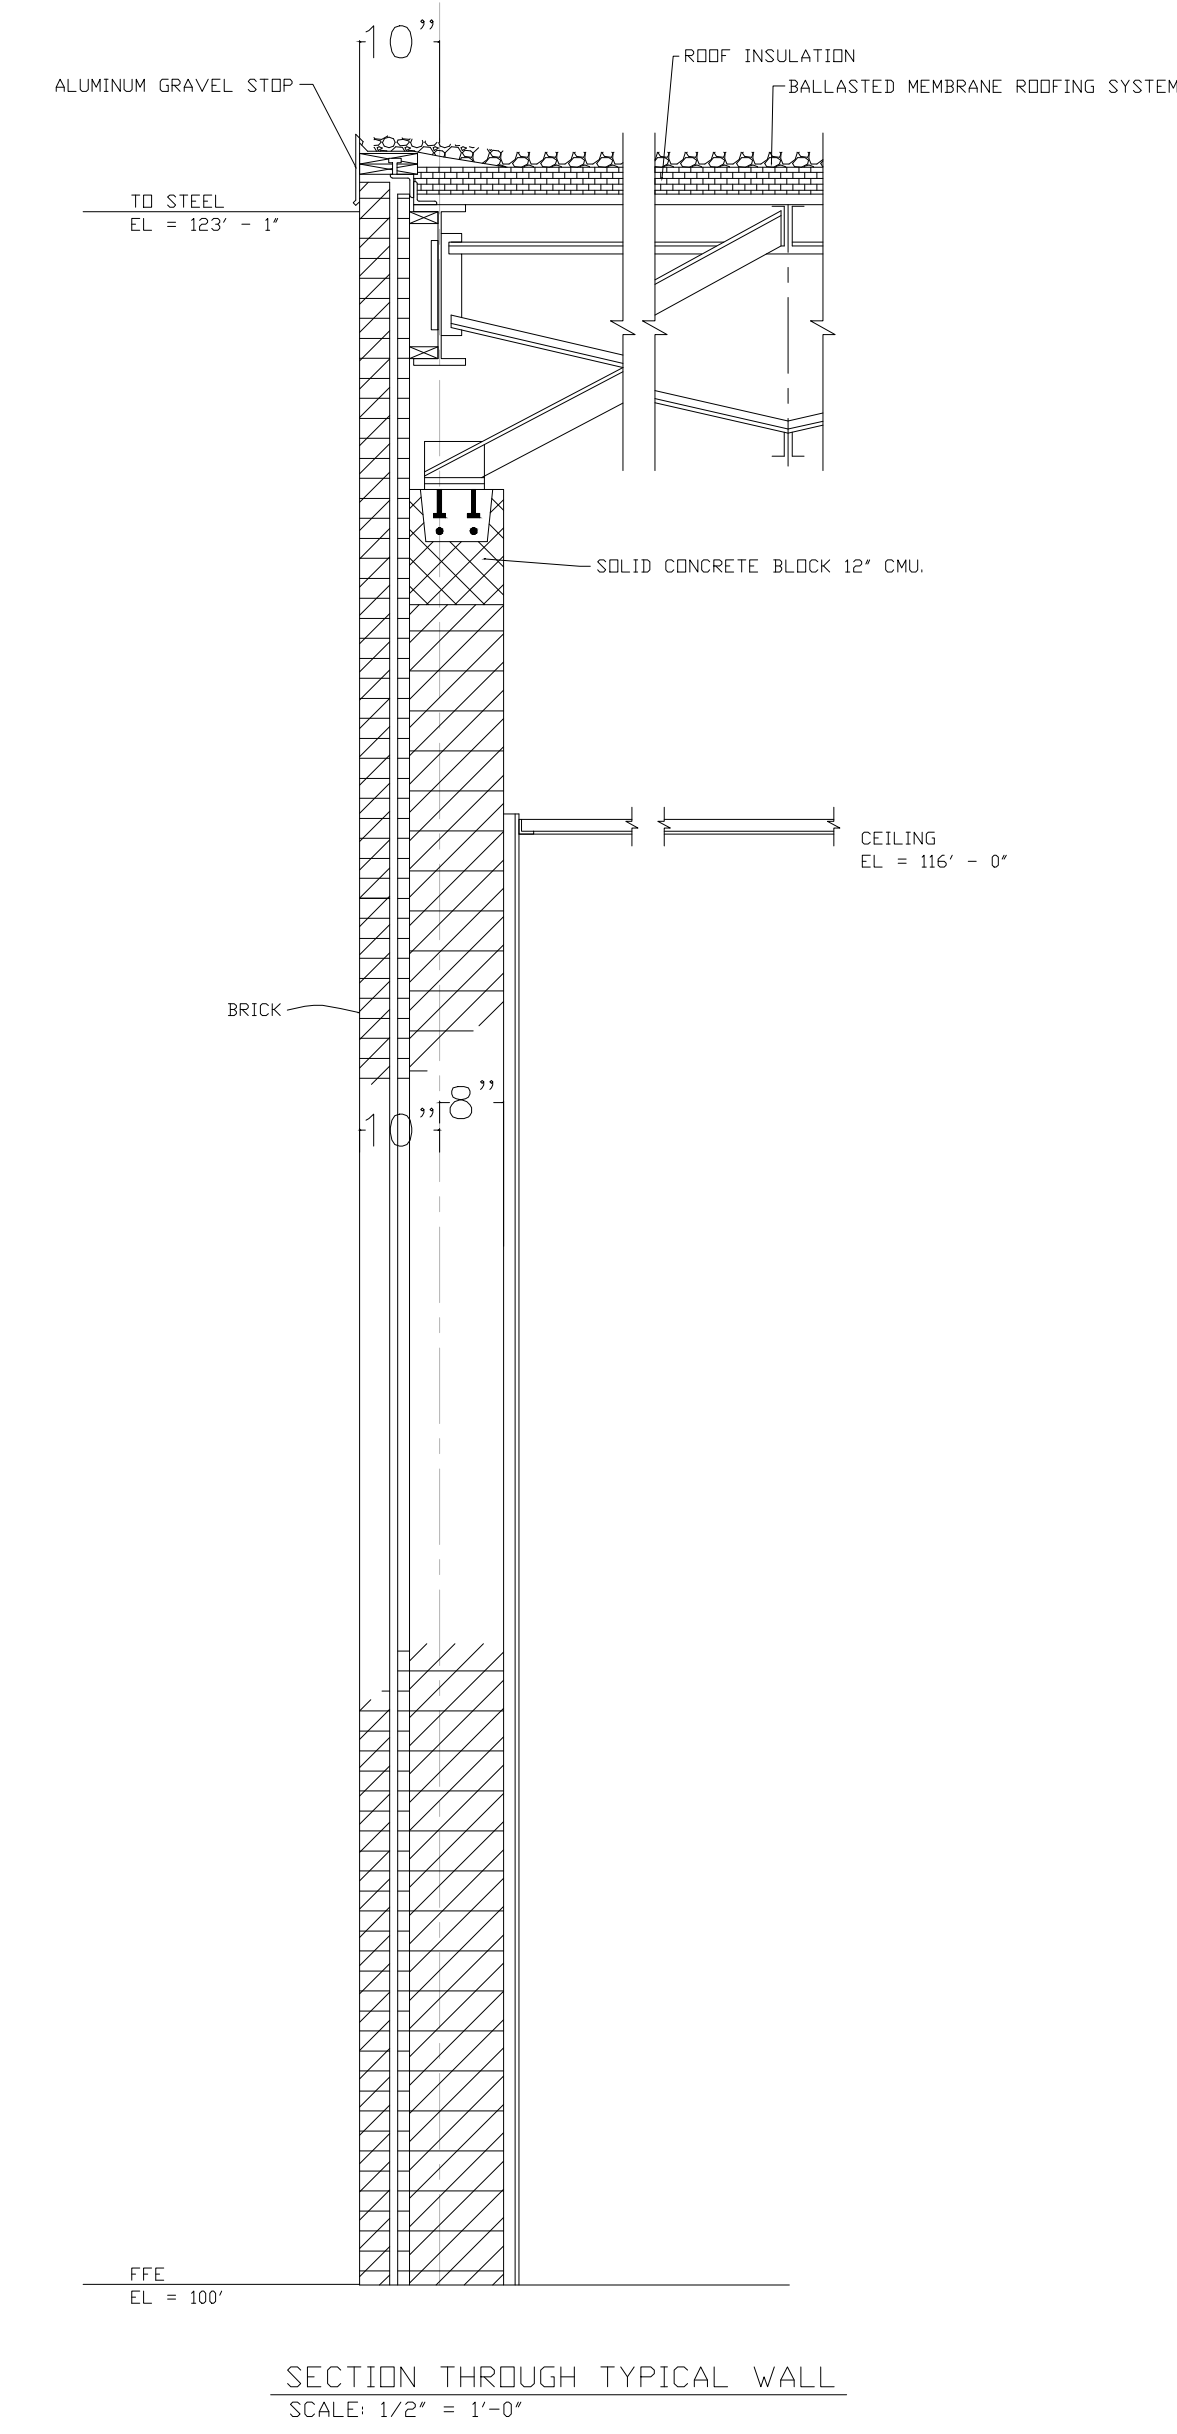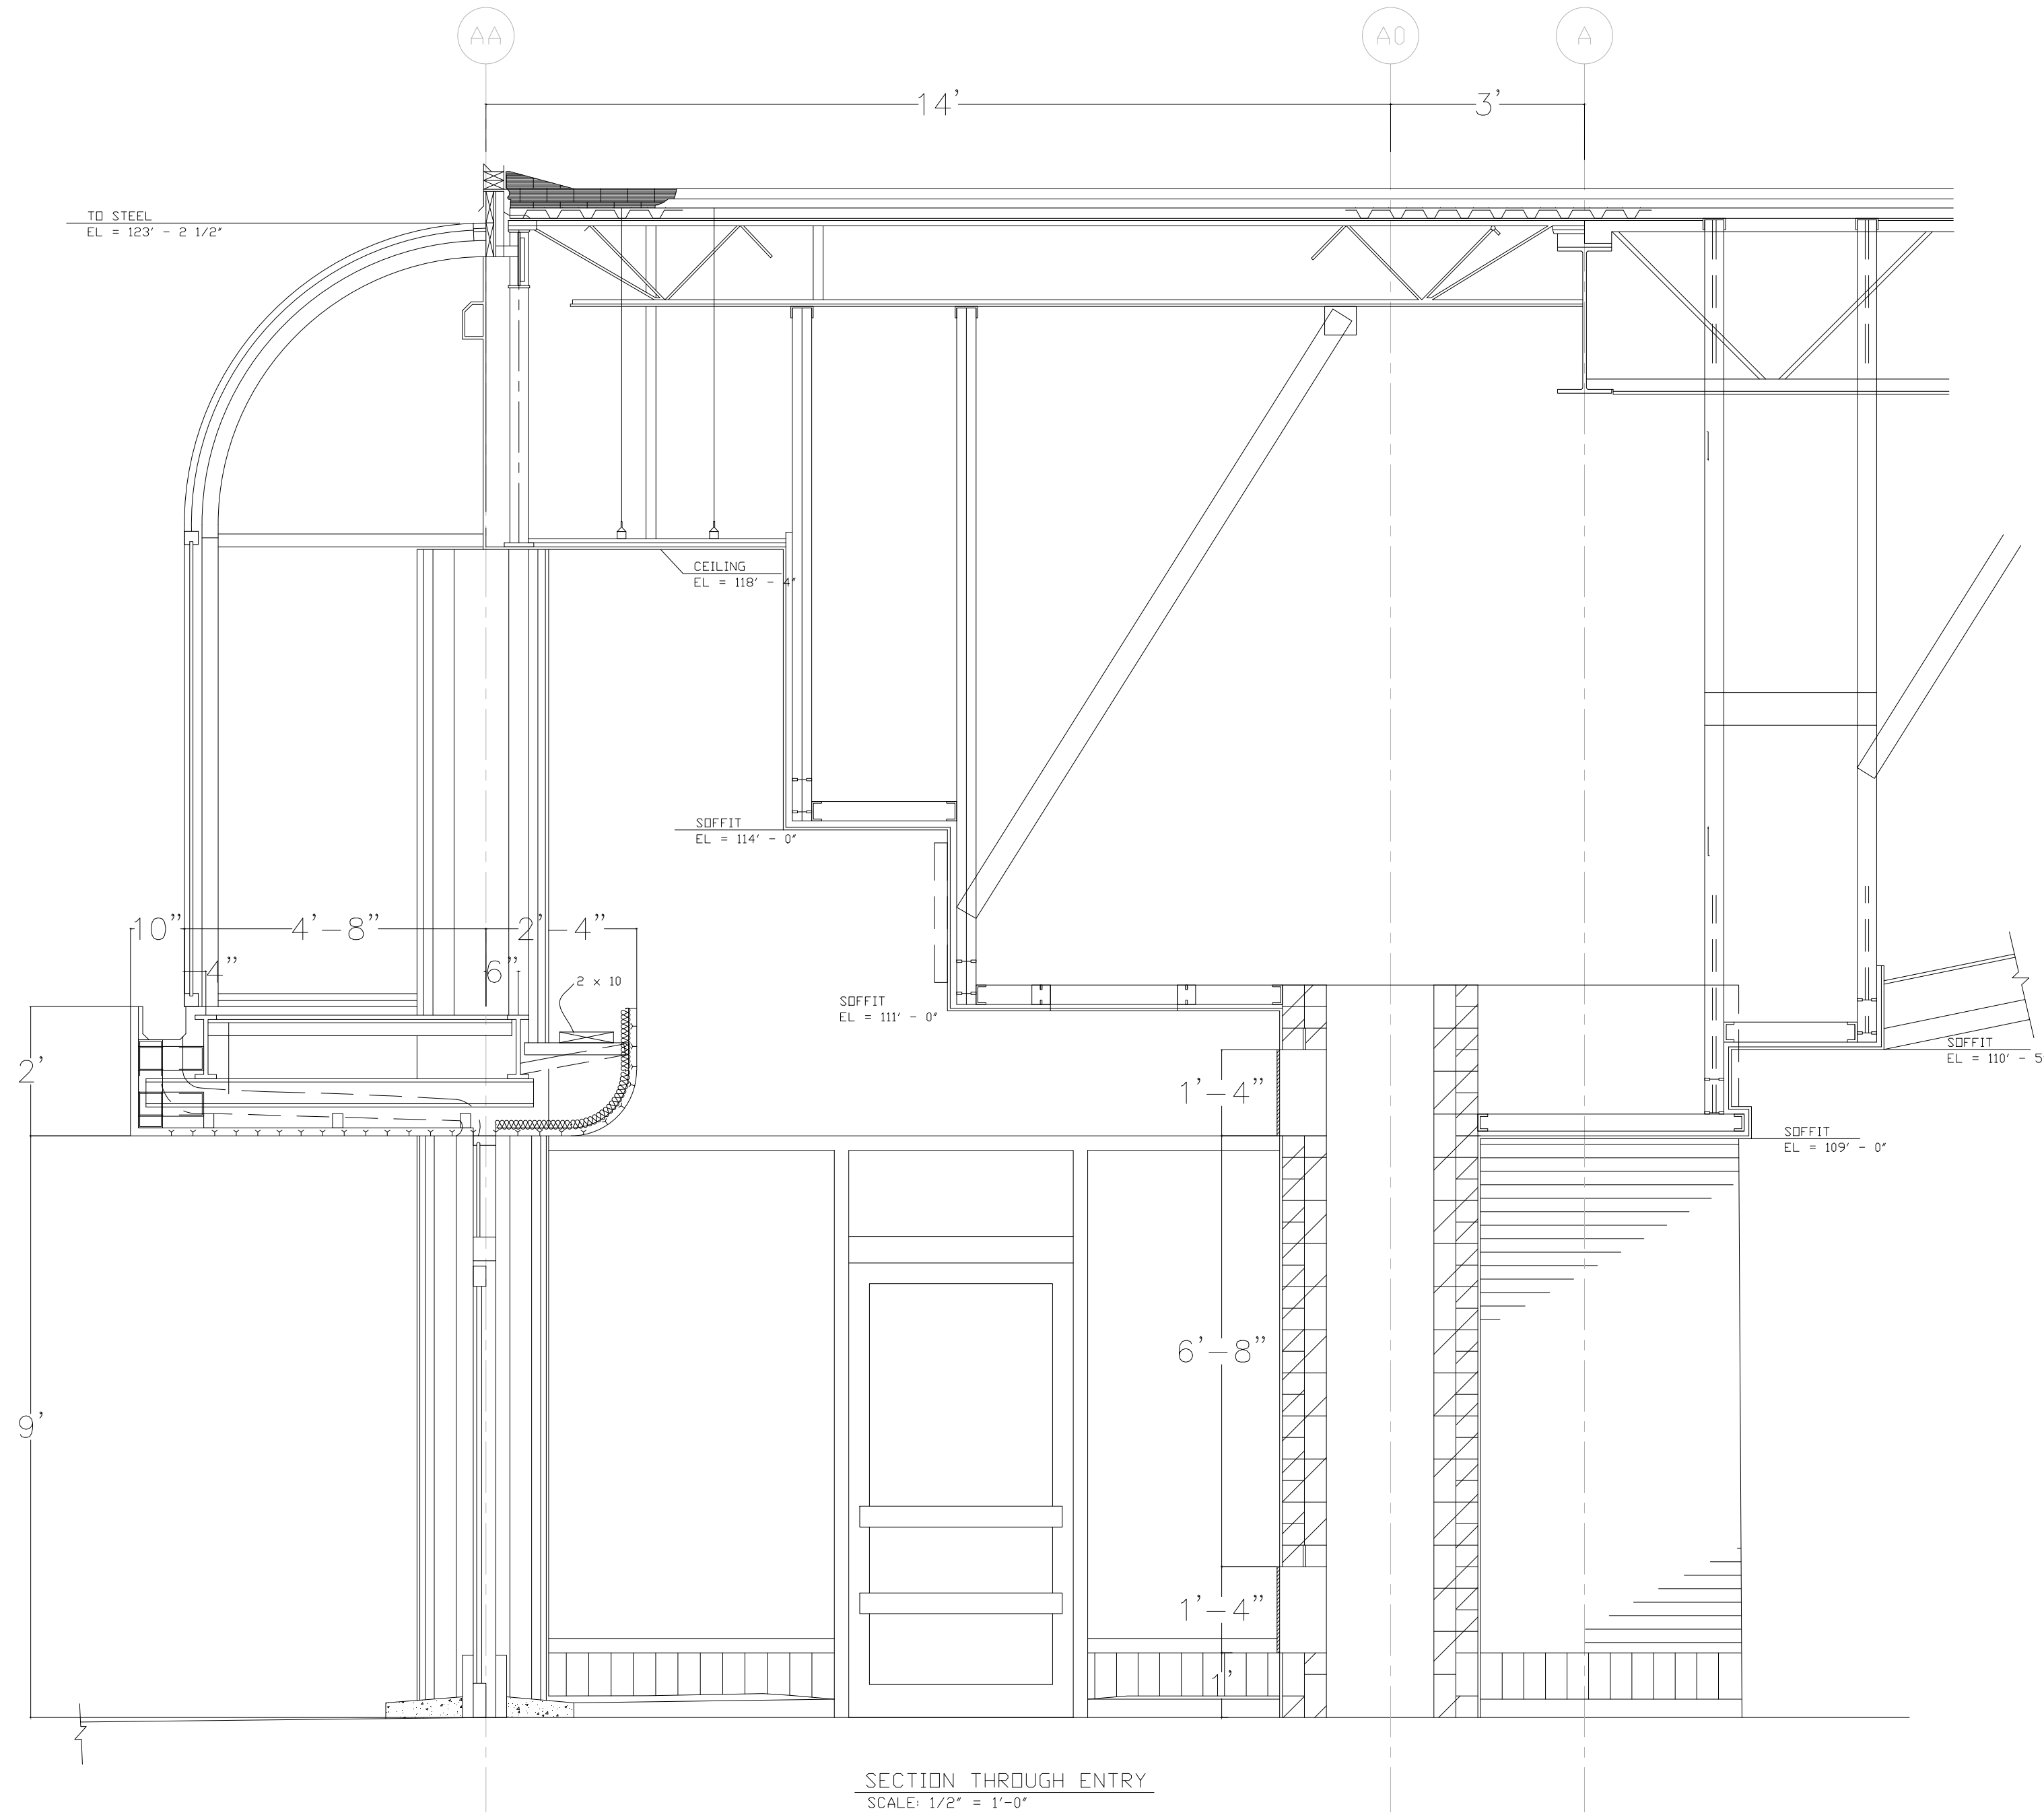

NO.	ISSUES   REVISIONS	DATE
01	100% SUBMISSION	

**BUILDING SECTIONS**

HL	PROJECT MANAGER
HL	PROJECT DIRECTOR
9-2-16-1	PROJECT NUMBER
AS NOTED	SCALE
CL	DRAWN BY
	SHEET NUMBER

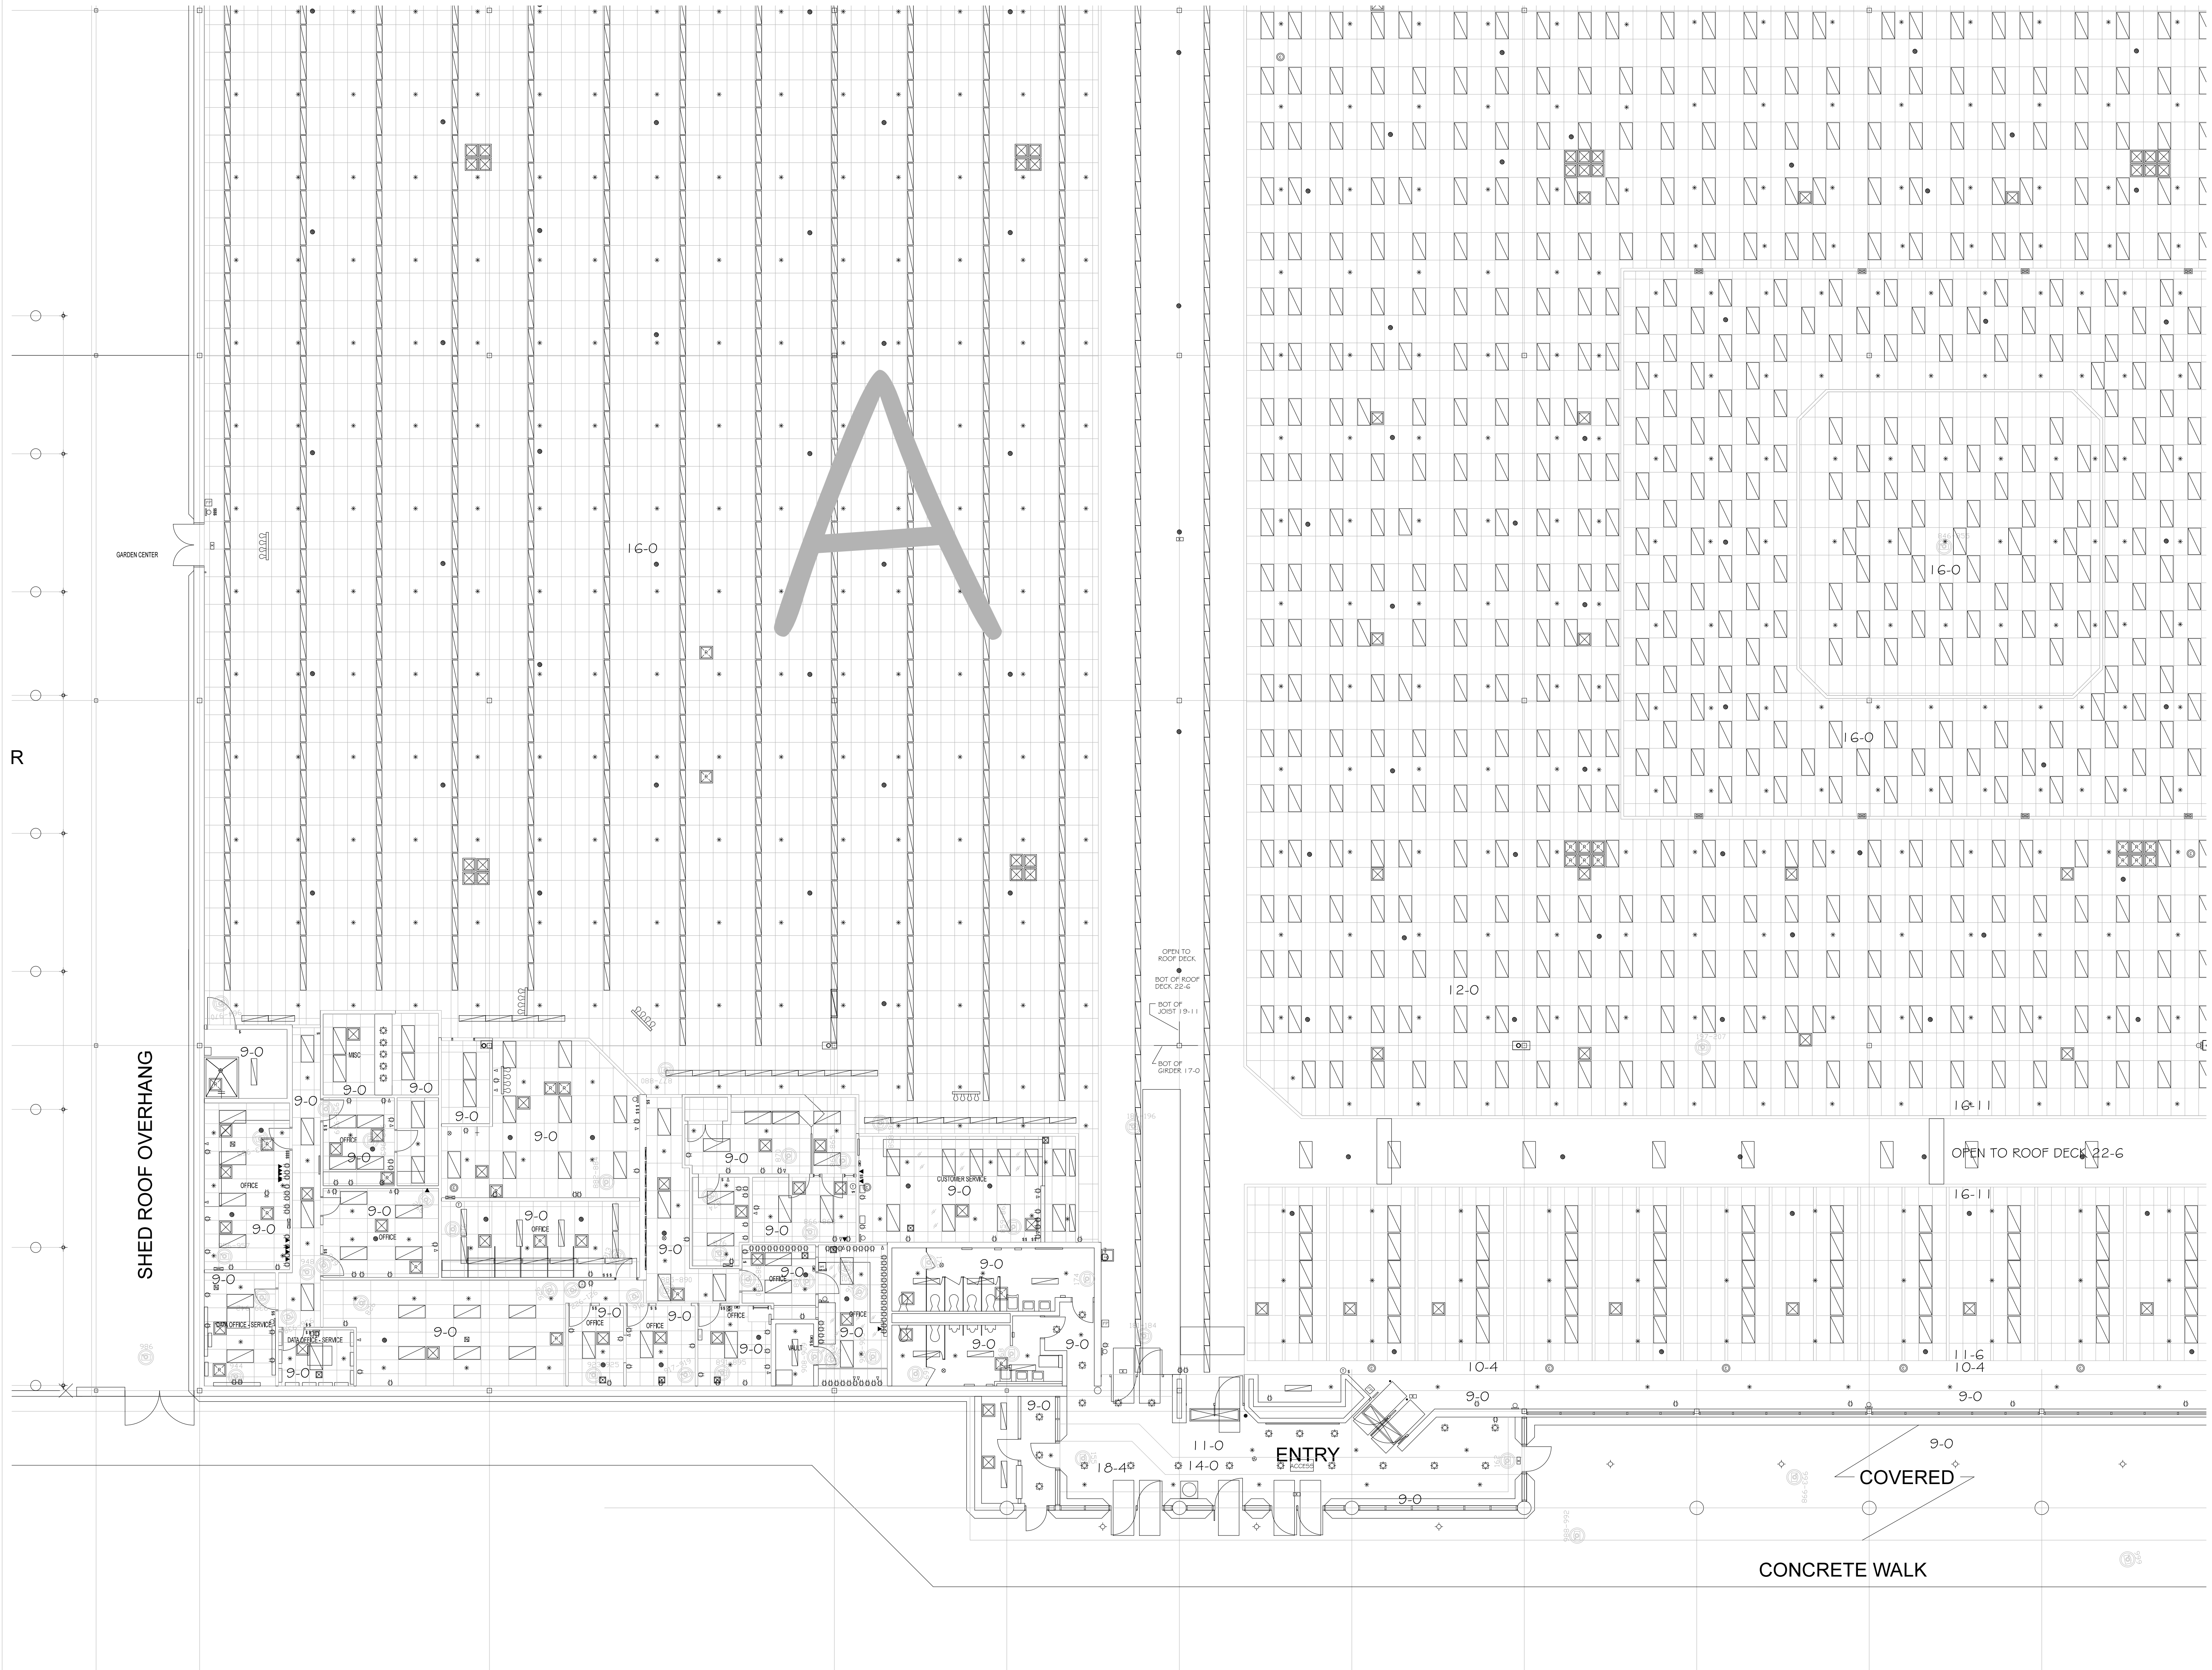


**ARCHITECTURAL AS BUILT**  
**COMMERCIAL FACILITY DOCUMENTATION**  
**5555 CLEVELAND AVENUE**  
**COLUMBUS, OHIO**

01	100% SUBMISSION	DATE
NO.	ISSUES   REVISIONS	DATE
		SHEET TITLE
<b>ENLARGED SECTION "A"</b>		
HL		PROJECT MANAGER
HL		PROJECT DIRECTOR
9-2-16-1		PROJECT NUMBER
AS NOTED		SCALE
CL		DRAWN BY
		SHEET NUMBER

**AB-7**



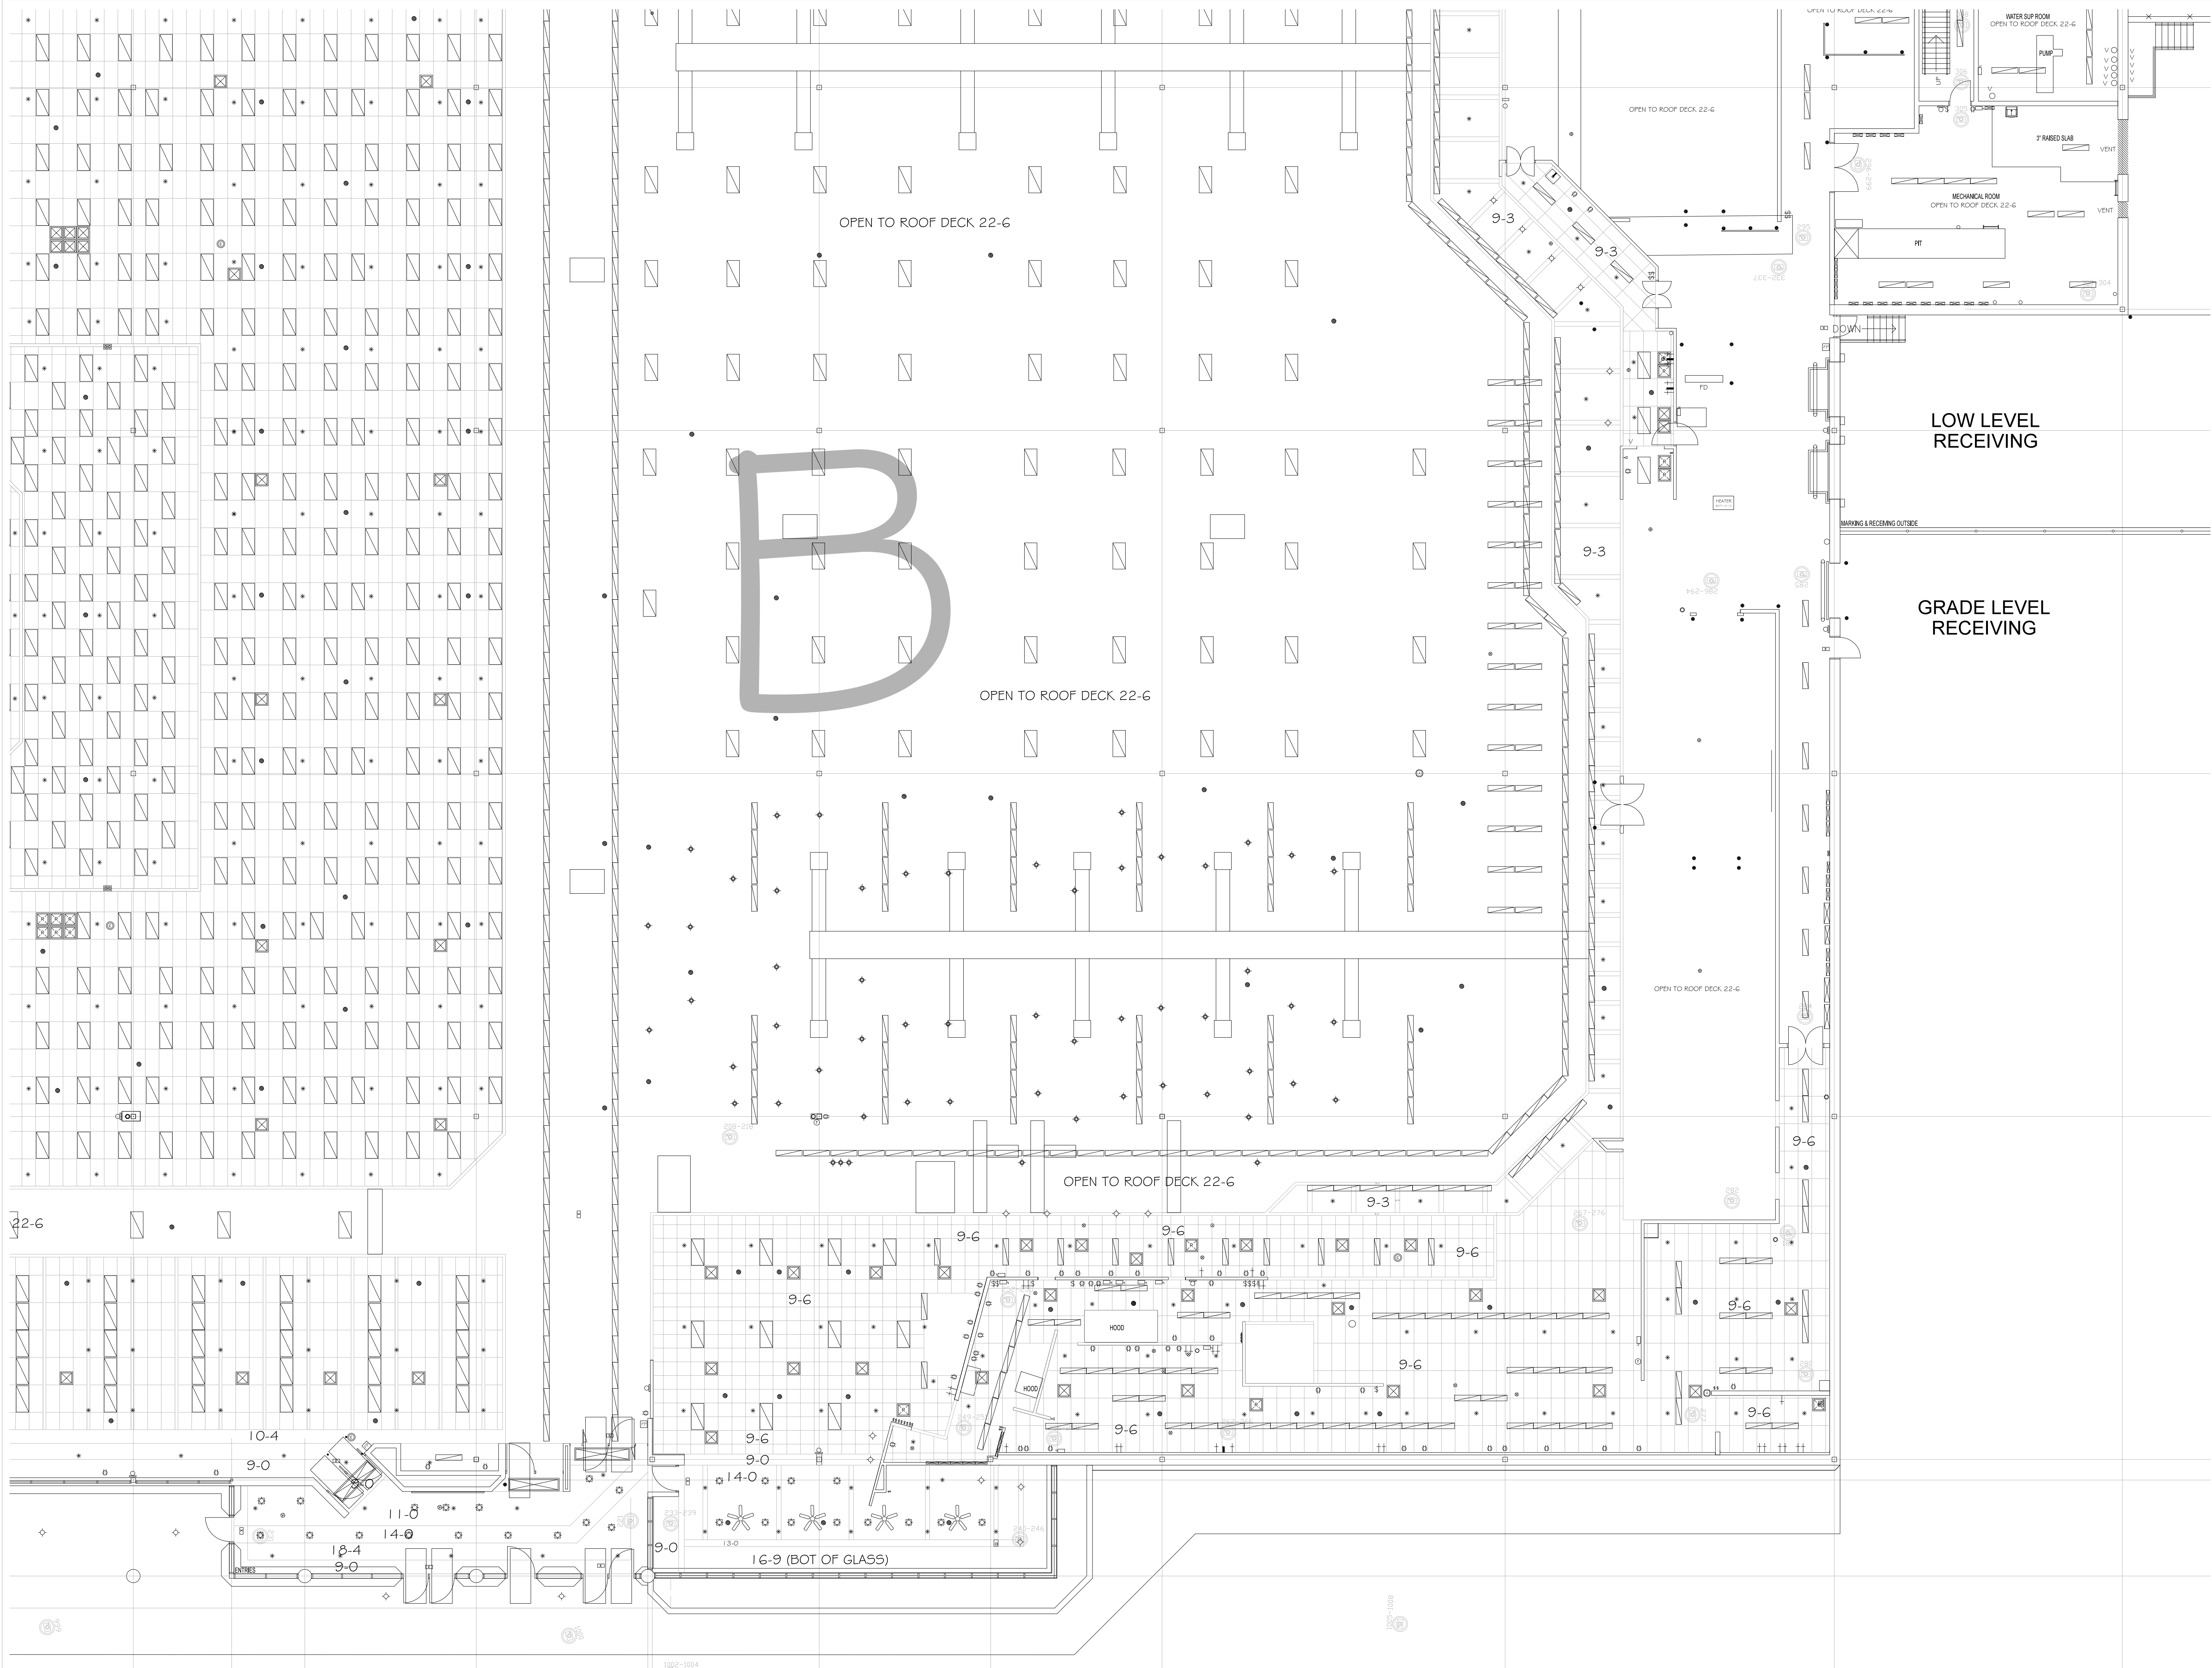

**AS BUILT**  
**PROFESSIONALS**  
 A DIVISION OF:

**AEC**  
 CONSULTANTS INC  
 www.aecconsultantsinc.com  
 844.272.8458

©2016 AEC CONSULTANTS INC.


**ARCHITECTURAL AS BUILT**  
**COMMERCIAL FACILITY DOCUMENTATION**  
**5555 CLEVELAND AVENUE**  
**COLUMBUS, OHIO**

NO.	ISSUES   REVISIONS	DATE	SHEET TITLE
01	100% SUBMISSION		

**ENLARGED SECTION "B"**

HL	PROJECT MANAGER
HL	PROJECT DIRECTOR
9-2-16-1	PROJECT NUMBER
AS NOTED	SCALE
CL	DRAWN BY
	SHEET NUMBER

**AB-8**

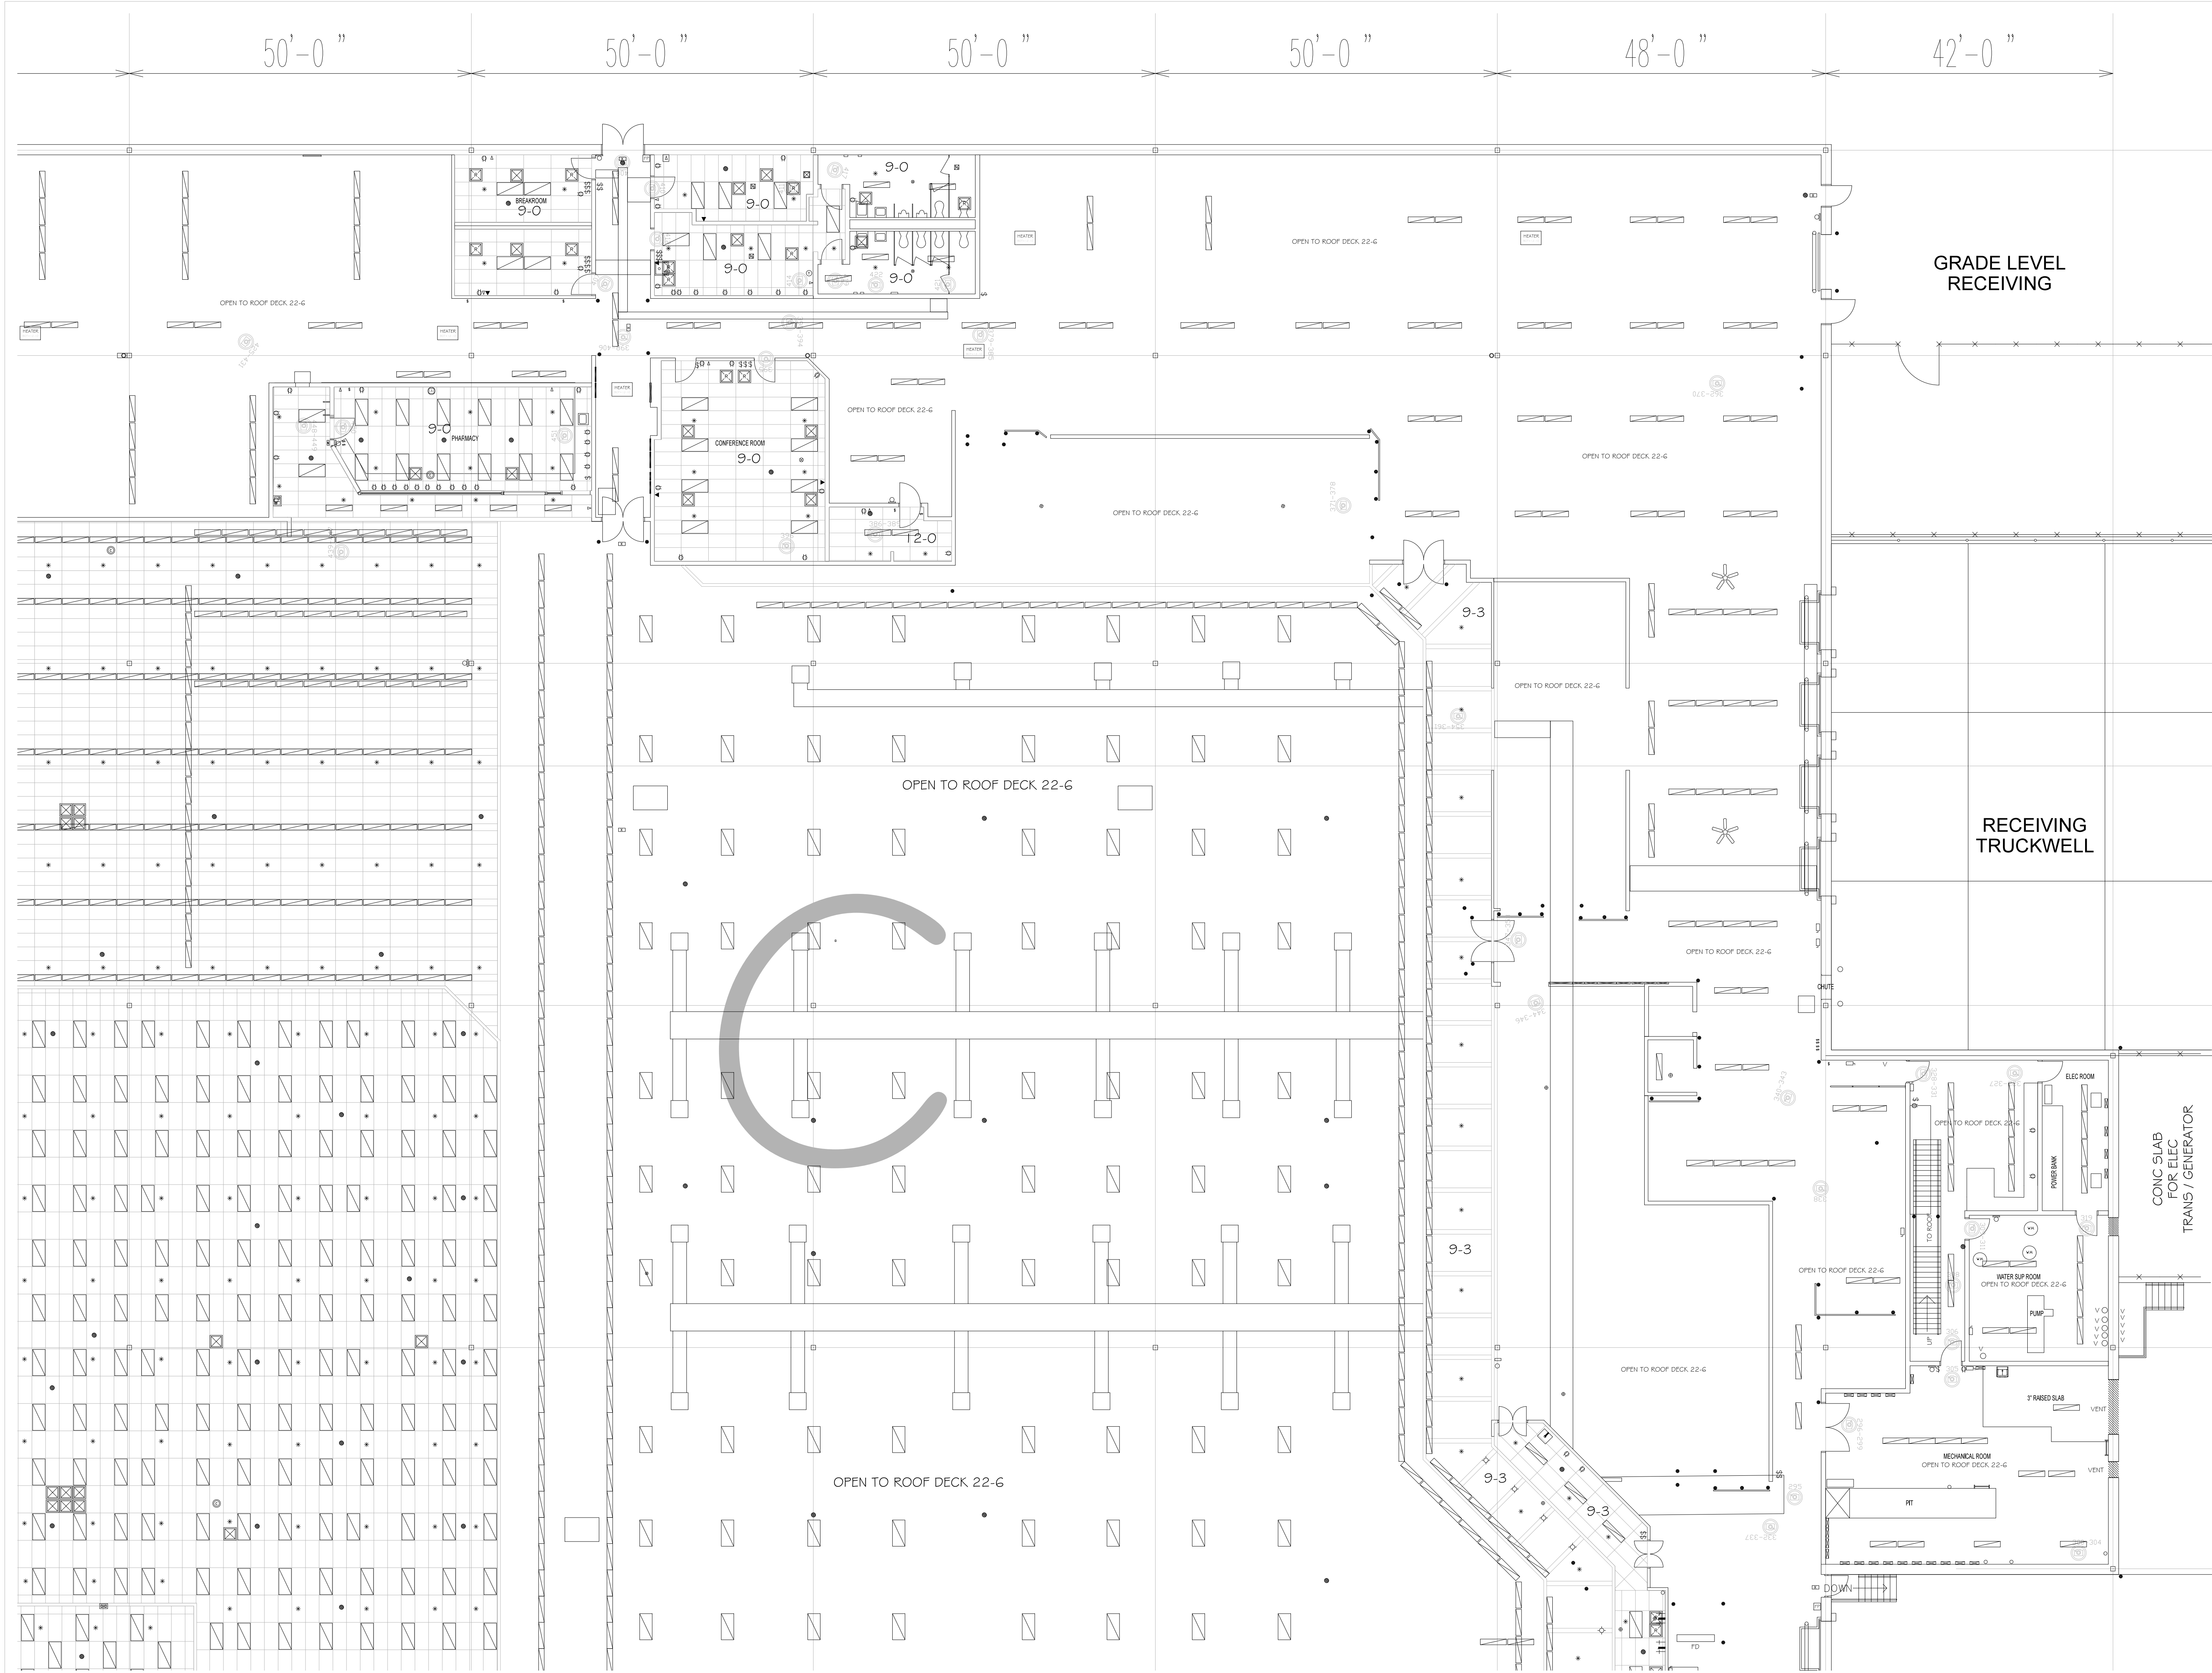

**AS BUILT**  
PROFESSIONALS

A DIVISION OF:

**AEC**

CONSULTANTS INC

www.aecconsultantsinc.com

844.272.8458

©2016 AEC CONSULTANTS, INC.


**ARCHITECTURAL AS BUILT**  
**COMMERCIAL FACILITY DOCUMENTATION**  
**5555 CLEVELAND AVENUE**  
**COLUMBUS, OHIO**

01	100% SUBMISSION	DATE
NL	ISSUES   REVISIONS	SHEET TITLE

**ENLARGED SECTION "C"**

HL	PROJECT MANAGER
HL	PROJECT DIRECTOR
9-2-16-1	PROJECT NUMBER
AS NOTED	SCALE
CL	DRAWN BY
	SHEET NUMBER

**AB-9**

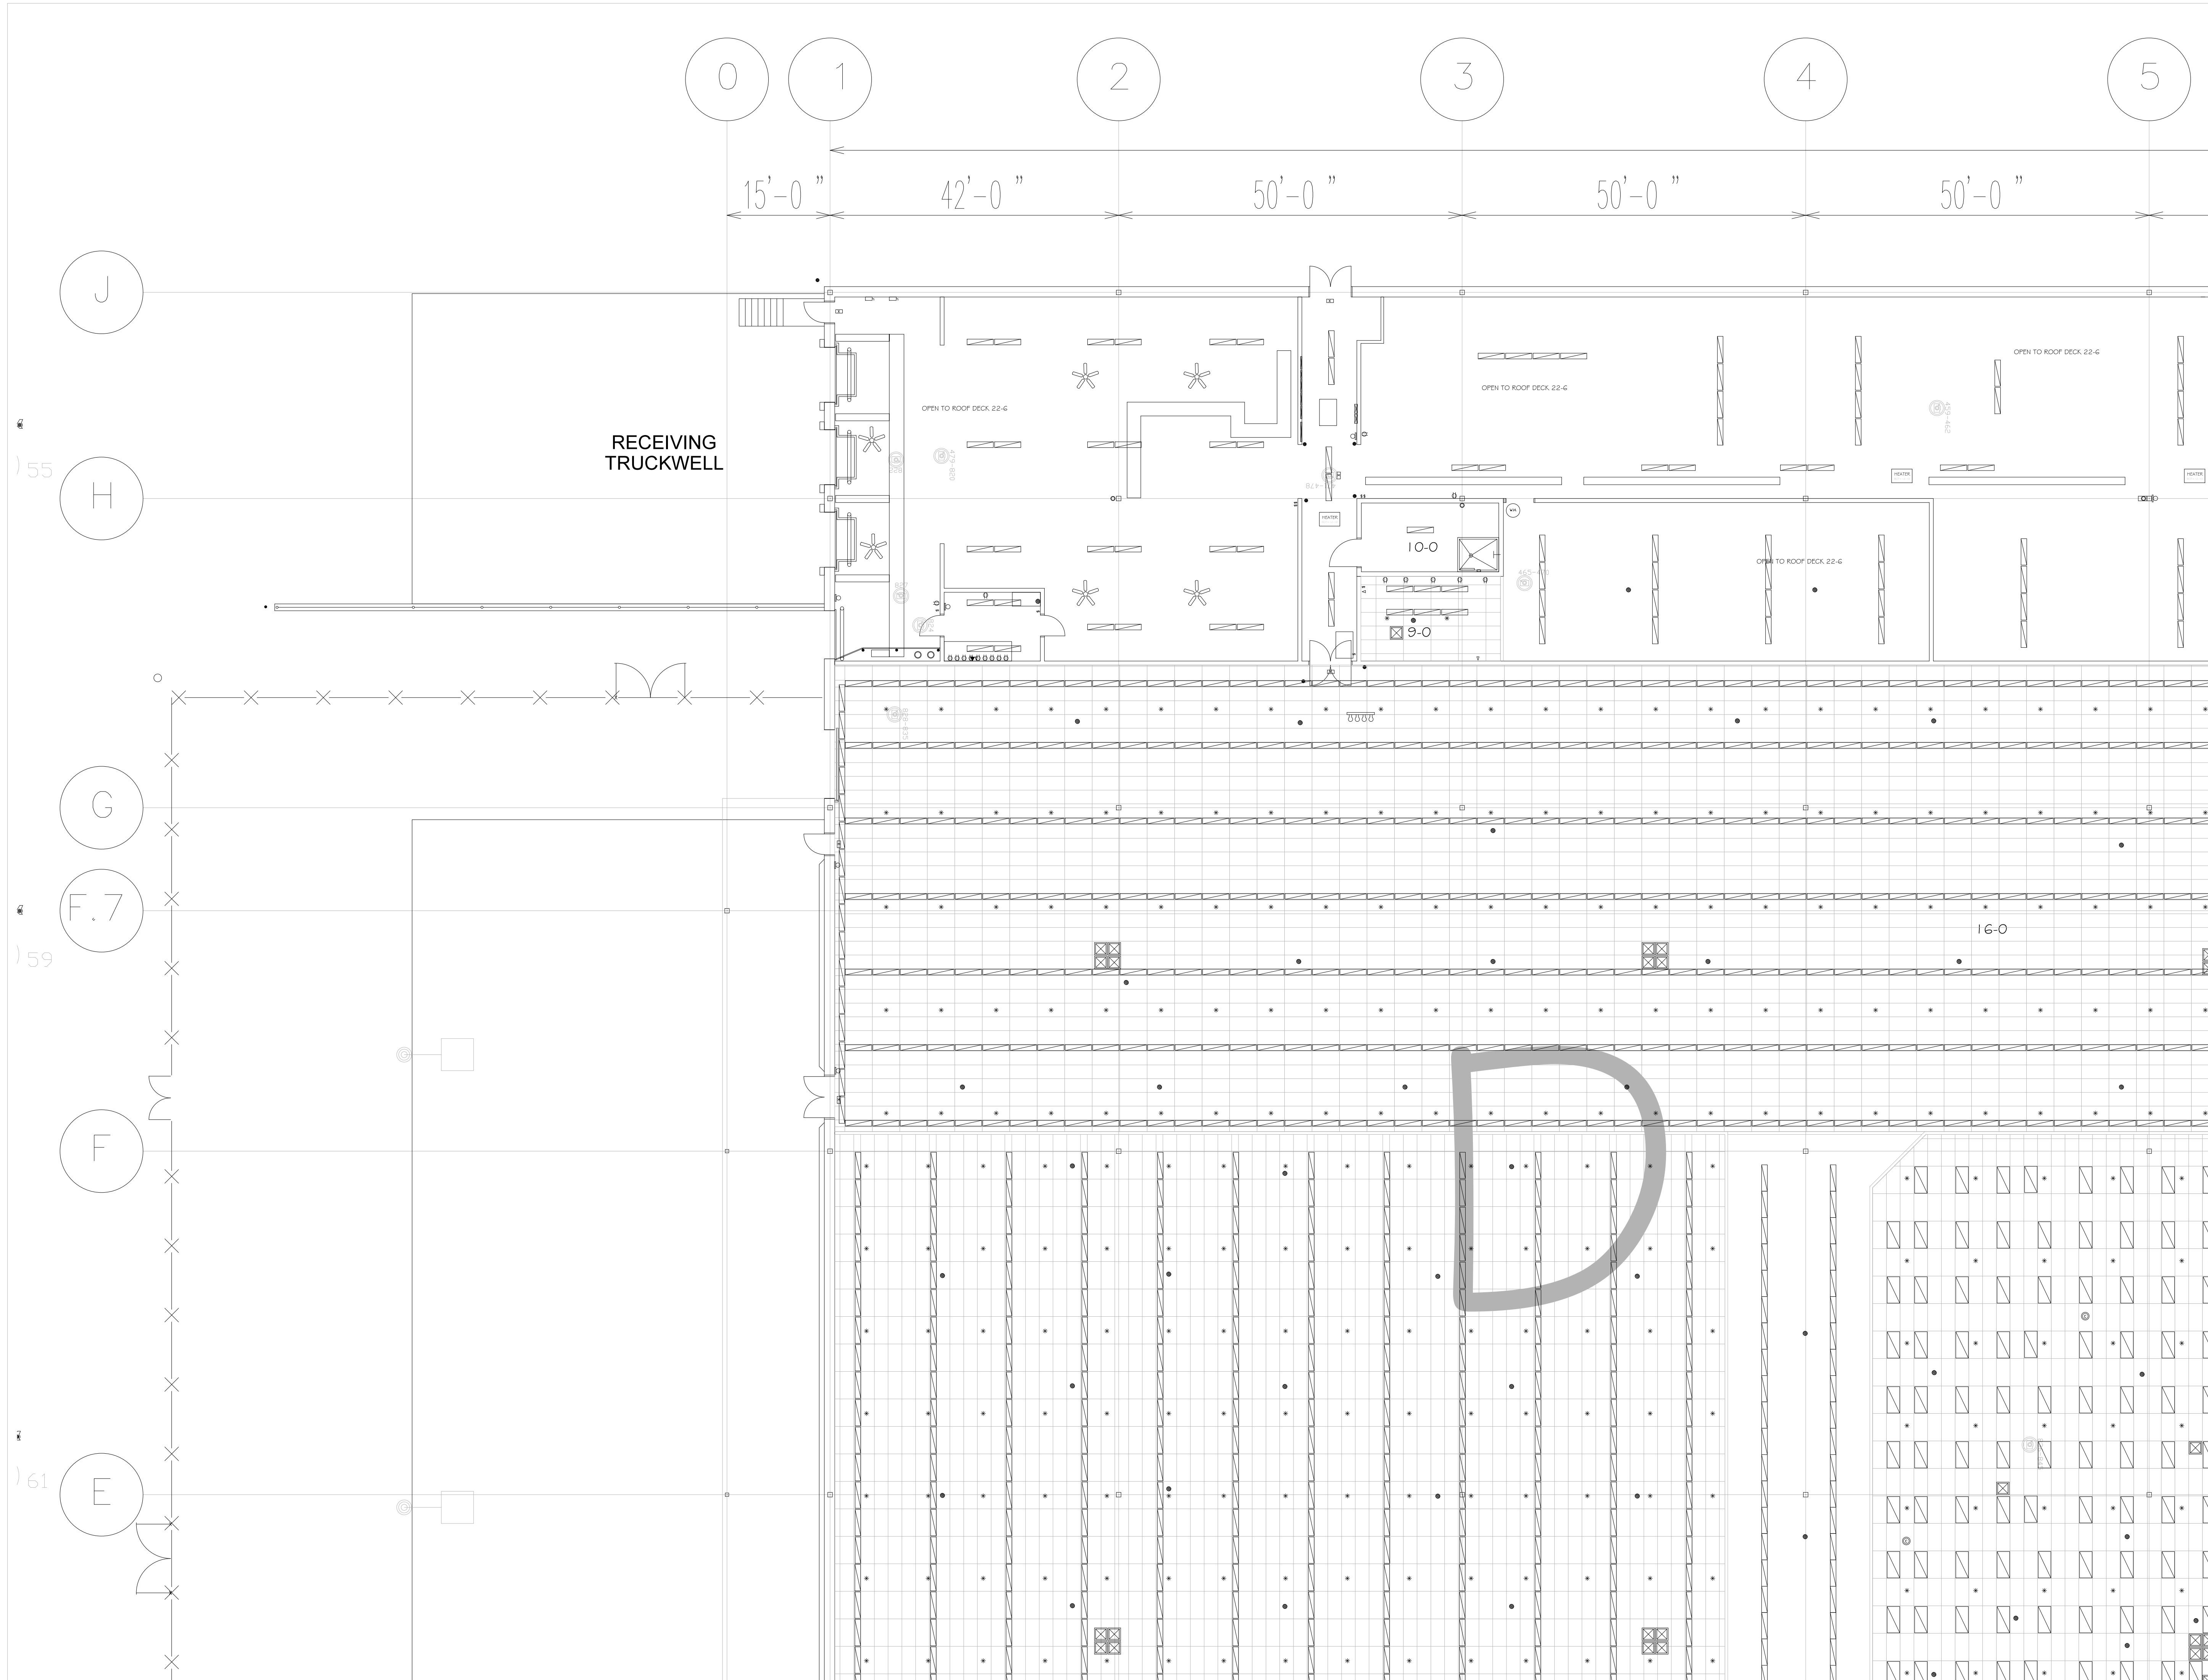

**ARCHITECTURAL AS BUILT**  
**COMMERCIAL FACILITY DOCUMENTATION**  
**5555 CLEVELAND AVENUE**  
**COLUMBUS, OHIO**

NO.	ISSUES   REVISIONS	DATE	SHEET TITLE
01	100% SUBMISSION		

**ENLARGED SECTION "D"**

HL	PROJECT MANAGER
HL	PROJECT DIRECTOR
9-2-16-1	PROJECT NUMBER
AS NOTED	SCALE
CL	DRAWN BY
	SHEET NUMBER

**AB-10**