


SYMBOLS LEGEND	
RCP	ELECTRIC
○ EXHAUST VENT	● DATA OUTLET
⊕ CEILING RECESSED LIGHT FIXTURE	⊕ TELEPHONE JACK
⊕ RECESSED CAN LIGHT	⊕ ELECTRIC SWITCH
⊕ INDIVIDUAL CLAMP	⊕ GROUND FLEXIBUSH
⊕ INDIVIDUAL PLUMB	⊕ SWITCH RECEPTACLE
⊕ INDIVIDUAL PLUMB WITH 2 P.S.S.	⊕ SWITCH WITH 2P SWITCH
⊕ INDIVIDUAL PLUMB WITH 2 P.S.S. & GROUND FLEXIBUSH	⊕ GROUNDABLE SWITCH
○ CAMERA	⊕ GROUNDABLE SWITCH
⊕ MOTOR SET	⊕ GROUNDABLE SWITCH
⊕ SUPPLY VENT	⊕ ELECTRIC PANEL
⊕ RETURN VENT	⊕ ELECTRIC METER
⊕ RETURN VENT	⊕ BUTTON SWITCH
⊕ RETURN VENT	⊕ RECEPTACLE
⊕ GROUND FLOOR LIGHT	⊕ GROUND FLOOR LIGHT
FIRE PROTECTION	
⊕ FIRE EXTINGUISHER	⊕ FIRE PULL
⊕ FIRE ALARM (NON-SMOKED)	⊕ FIRE ALARM (NON-SMOKED)
⊕ SMOKE DETECTOR	⊕ SMOKE DETECTOR
⊕ SPRINKLER HEAD	⊕ SPRINKLER HEAD
MEP	
○ THERMISTAT	○ THERMISTAT
○ FLOOR BURN	○ FLOOR BURN
○ VALVE	○ VALVE
○ HIDE BOX	○ HIDE BOX
○ 7-2-G TELLING HEIGHT AND TYPE WITH 200V 400V 600V 800V 1000V	
○ SWEATER	

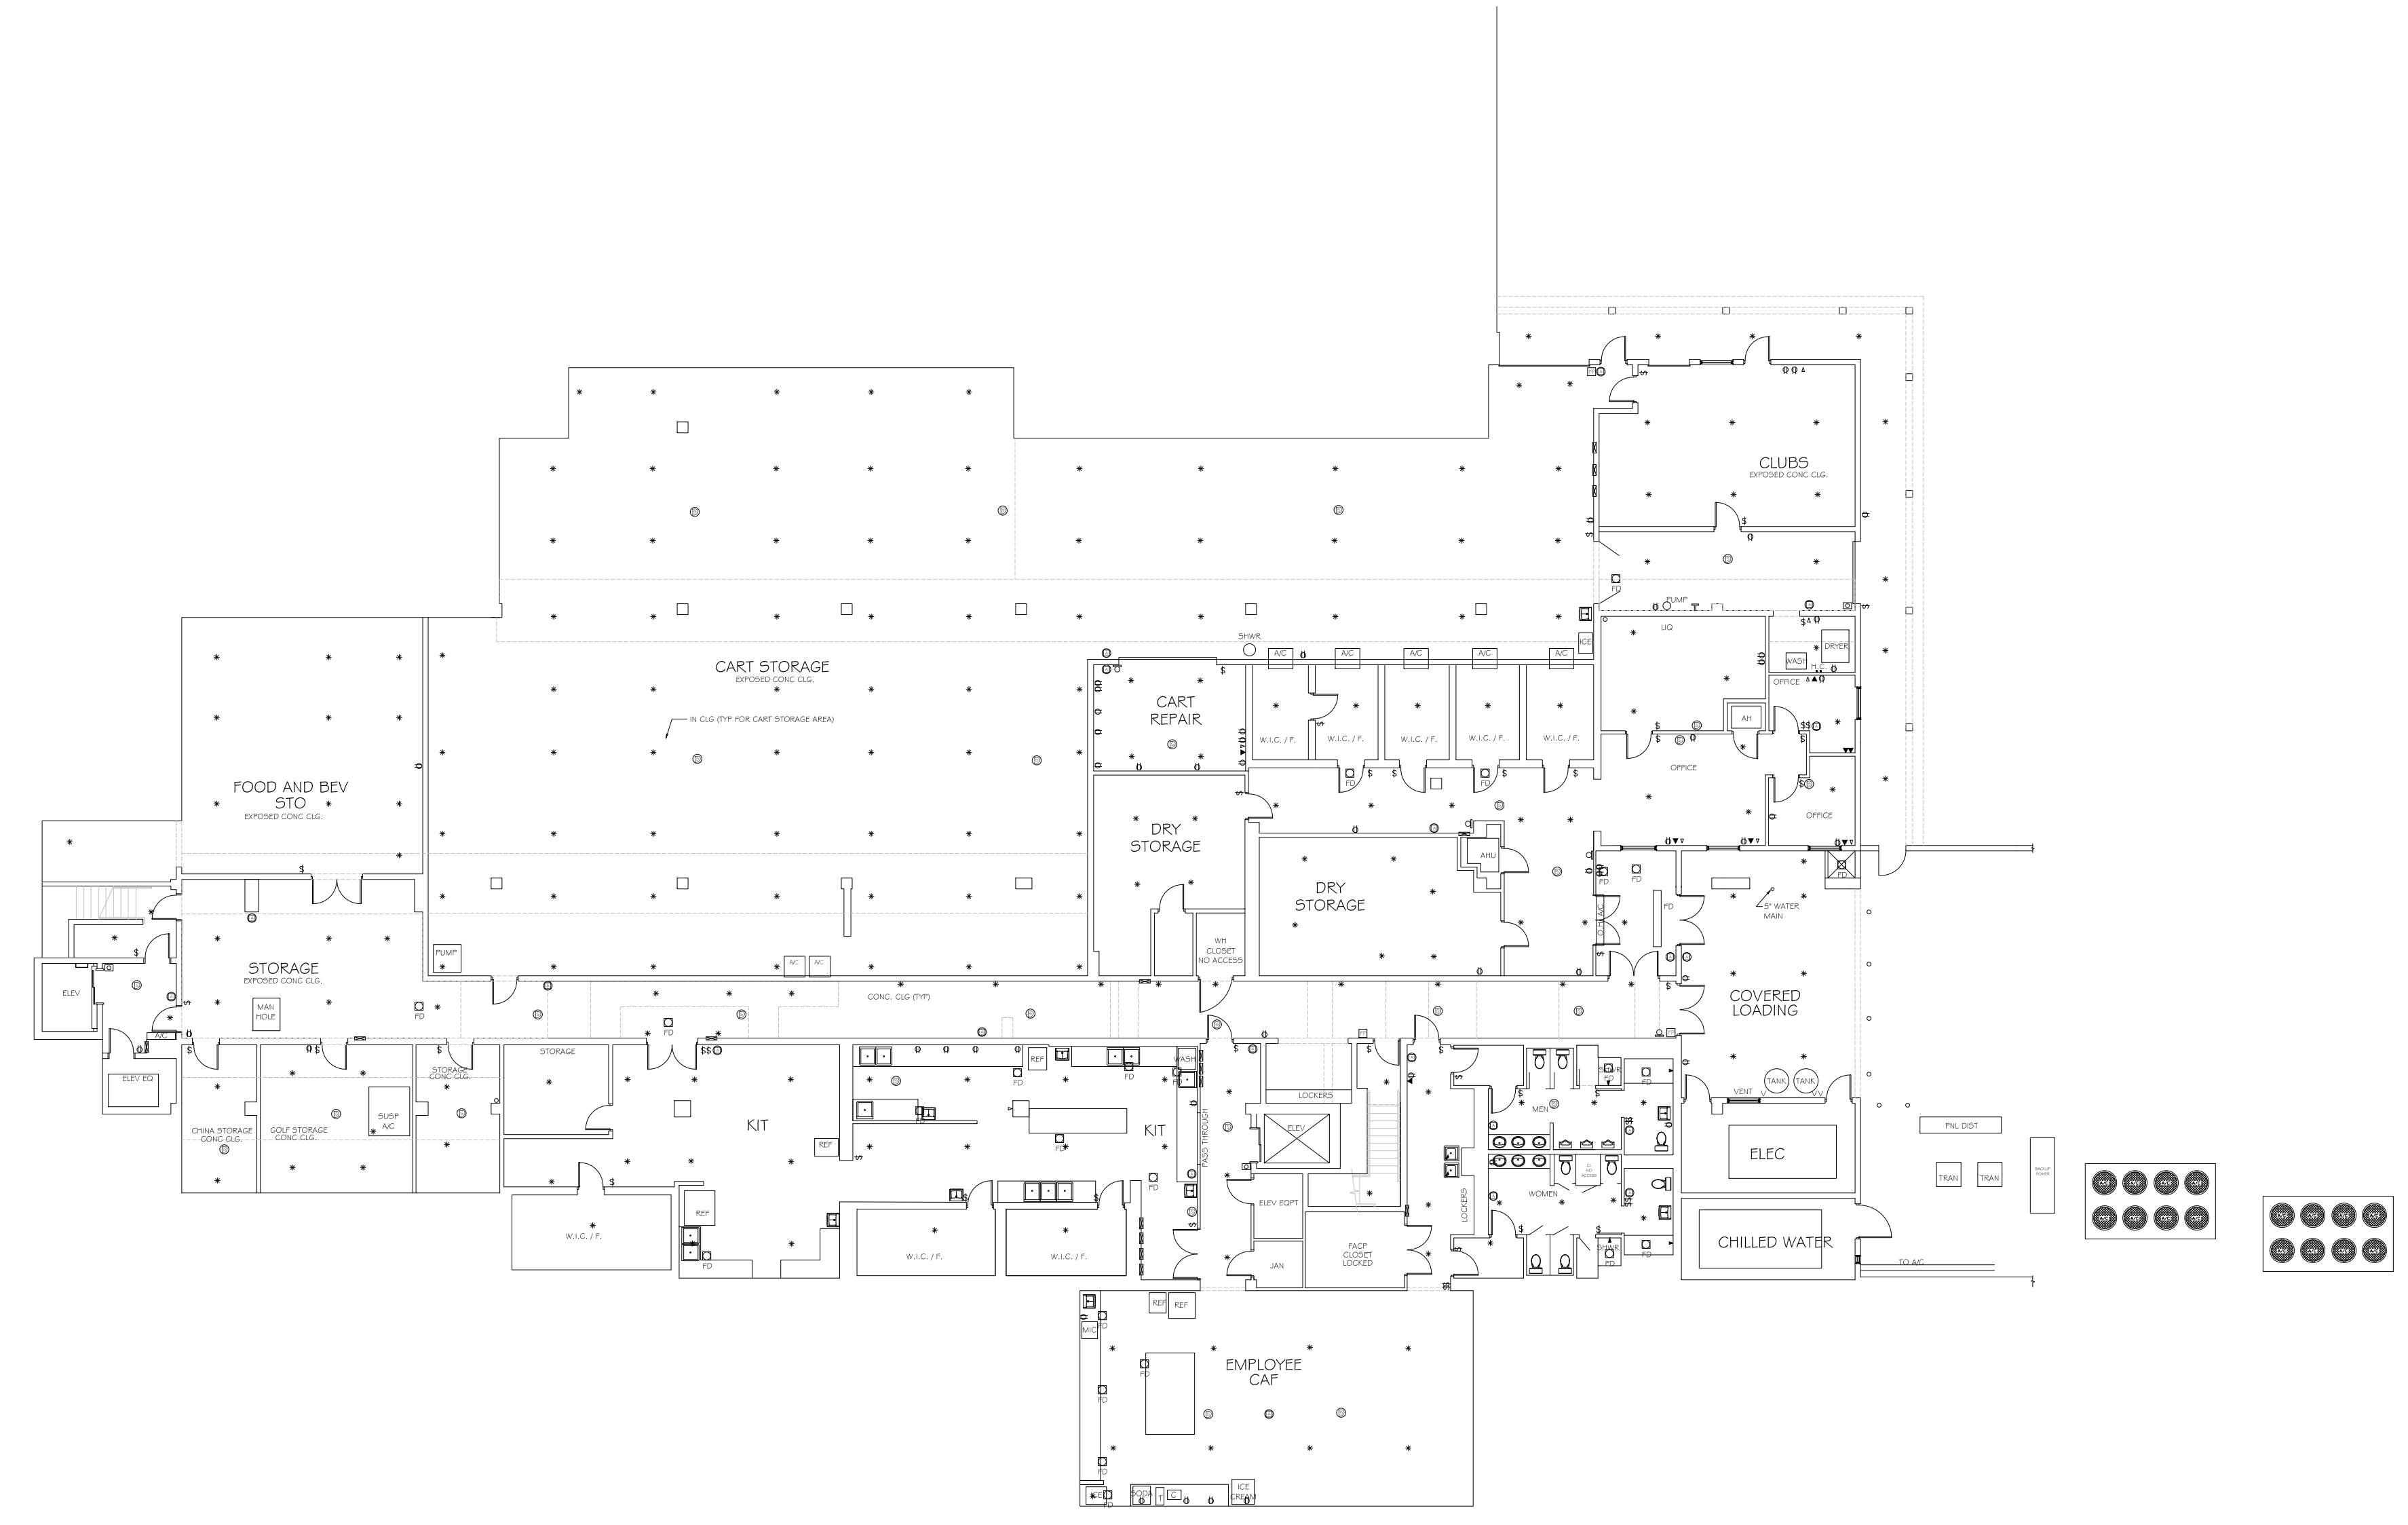

BASEMENT FLOOR PLAN
1/16" = 1'-0"

AS BUILT PROFESSIONALS
A DIVISION OF:
AEC CONSULTANTS INC
www.aeccconsultantsinc.com
844.272.8458
© 2016 AEC CONSULTANTS INC

AS BUILT DOCUMENTATION:
BALLEN ISLES COUNTRY CLUB
100 Ballen Isles Circle Palm Beach Gardens, FL 33418

NO.	ISSUES REVISIONS	DATE
01		

SHEET TITLE	
Fire Protection Plans (Basement)	
XX	PROJECT MANAGER
HL	PROJECT DIRECTOR
XX.XX.XX	PROJECT NUMBER
AS NOTED	SCALE
XX	DRAWN BY
	SHEET NUMBER

XFP201

