


AS-BUILT DOCUMENTATION

ITALIAN RENAISSANCE RESIDENCE


115 N. Rossmore Ave Los Angeles, CA 90004

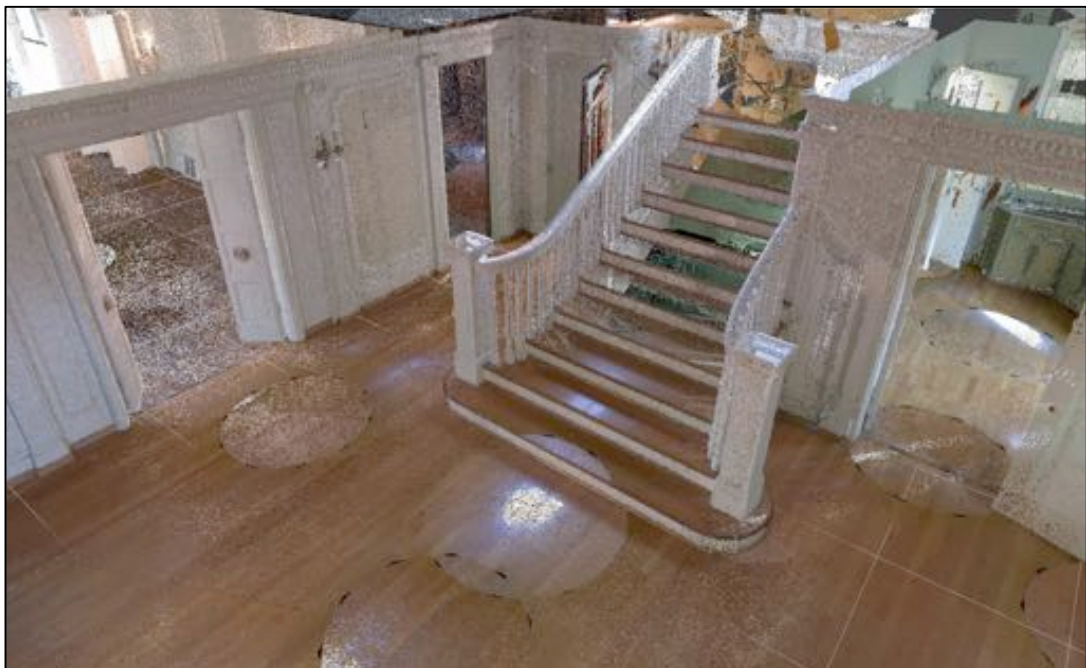

3D LIDAR POINT CLOUD 23

DRAWING INDEX

- C-1 COVER SHEET | DRAWING INDEX
- SL SYMBOLS LEGEND
- AB-1 EXTERIOR ELEVATIONS (RESIDENC
- AB-2 EXTERIOR ELEVATIONS (RESIDENC
- AB-3 BASEMENT FLOOR PLAN
- AB-4 FIRST FLOOR PLAN
- AB-5 SECOND FLOOR PLAN
- AB-6 ATTIC FLOOR PLAN
- AB-7 POOL CABANA FLOOR PLAN
- AB-8 GARAGE FIRST FLOOR PLAN
- AB-9 GARAGE SECOND FLOOR PLAN
- AB-10 ROOF PLAN (RESIDENCE)

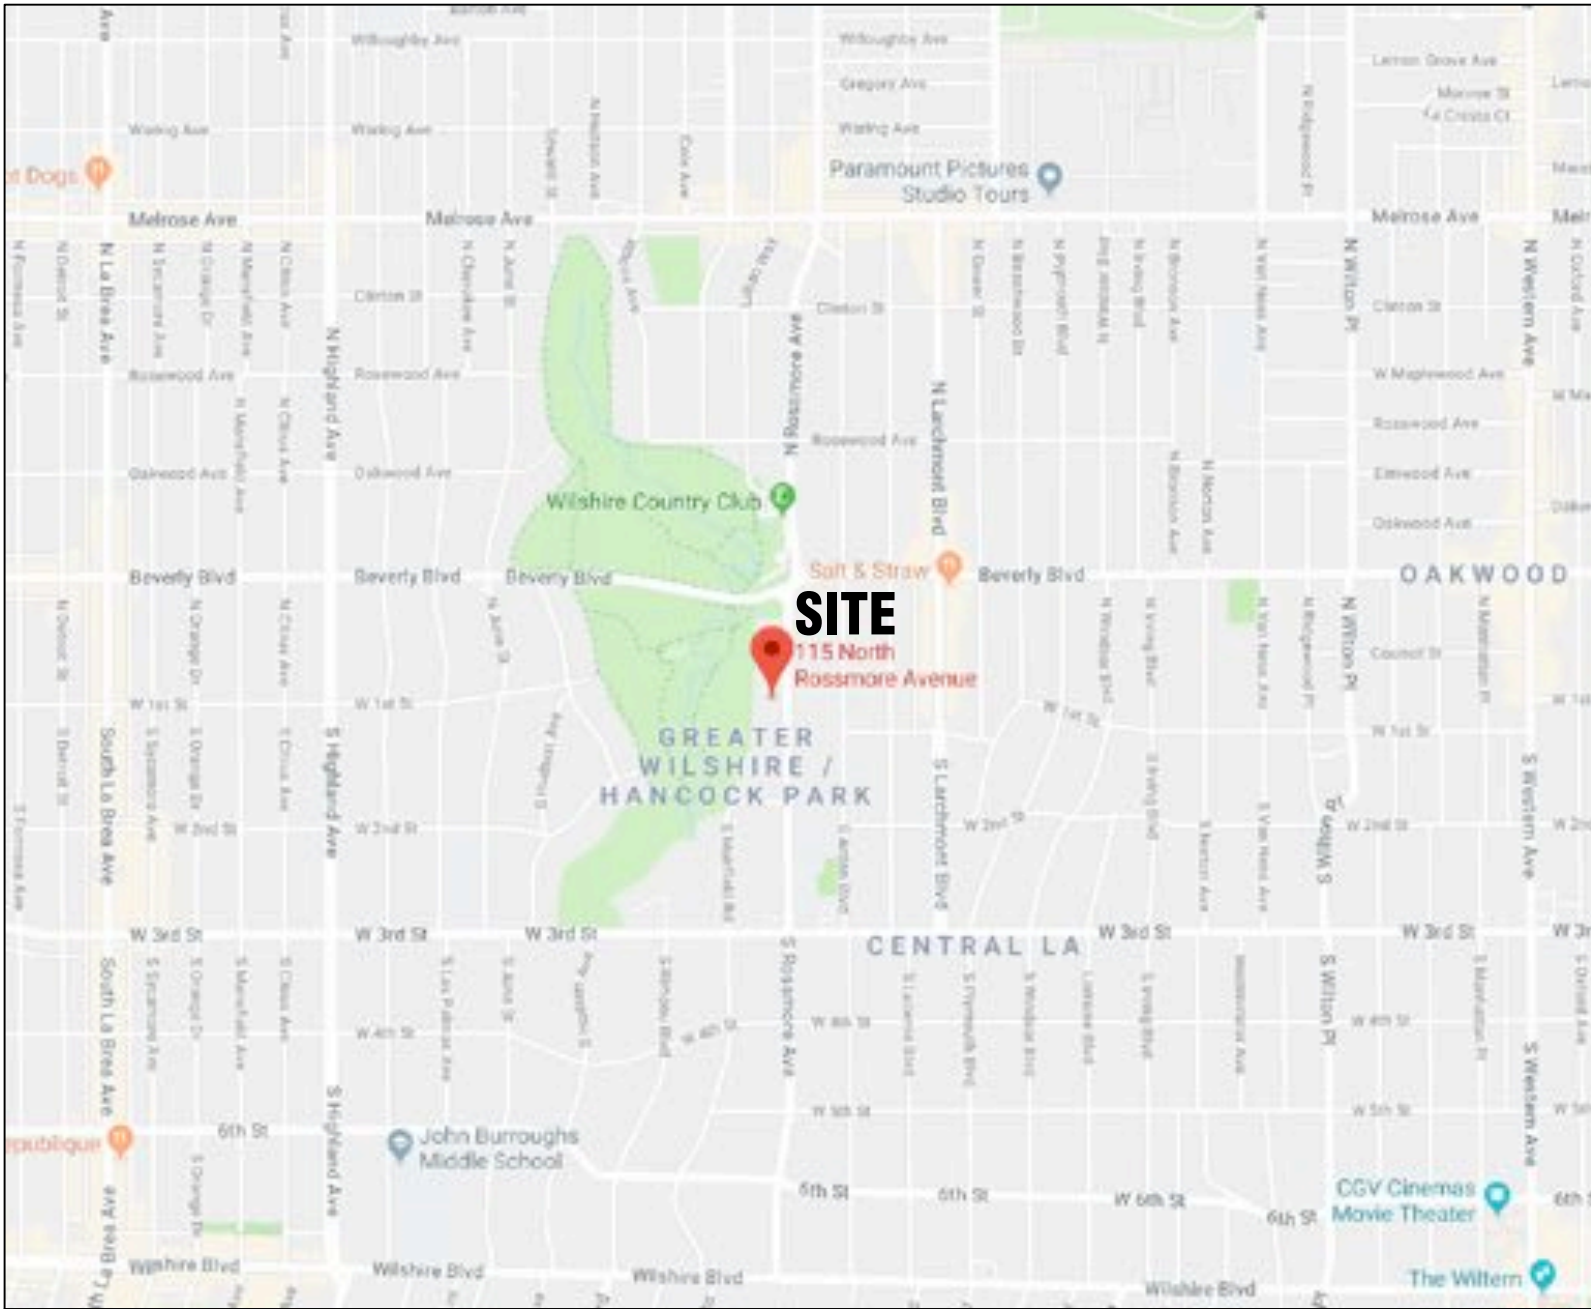

VICINITY MAP
NTS

AREA DATA	
BASEMENT	576 S.F. ±
FIRST FLOOR	3,935 S.F. ±
SECOND FLOOR	3,288 S.F. ±
ATTIC	771 S.F. ±
CABANA	1,664 S.F. ±
GARAGE	1,614 S.F. ±
GRAND TOTAL	11,848 S.F. ±

As BUILT

PROFESSIONALS

www.asbuiltprofessionals.com

A DIVISION OF:

AEC

CONSULTANTS INC

844.272.8458

844 ASBUILT

© 2018 AEC CONSULTANTS INC

ARCHITECTURAL AS BUILT
ITALIAN RENAISSANCE RESIDENCE
115 N. Rossmore Ave
Los Angeles, CA 90004

100% SUBMITTAL

C-1



FRONT ELEVATION



REAR ELEVATION




**ARCHITECTURAL AS BUILT
ITALIAN RENAISSANCE RESIDENCE**

**115 N. Rossmore Ave
Los Angeles, CA 90004**

01	100% SUBMISSION	SEE COVER SHEET
NO.	ISSUES / REVISIONS	DATE
		SHEET TITLE
FRONT / REAR ELEVATIONS		
HL		PROJECT MANAGER
HL		PROJECT DIRECTOR
012518-1		PROJECT NUMBER
1/4"=1'-0"		SCALE
CL		DRAWN BY
		SHEET NUMBER

AB-1

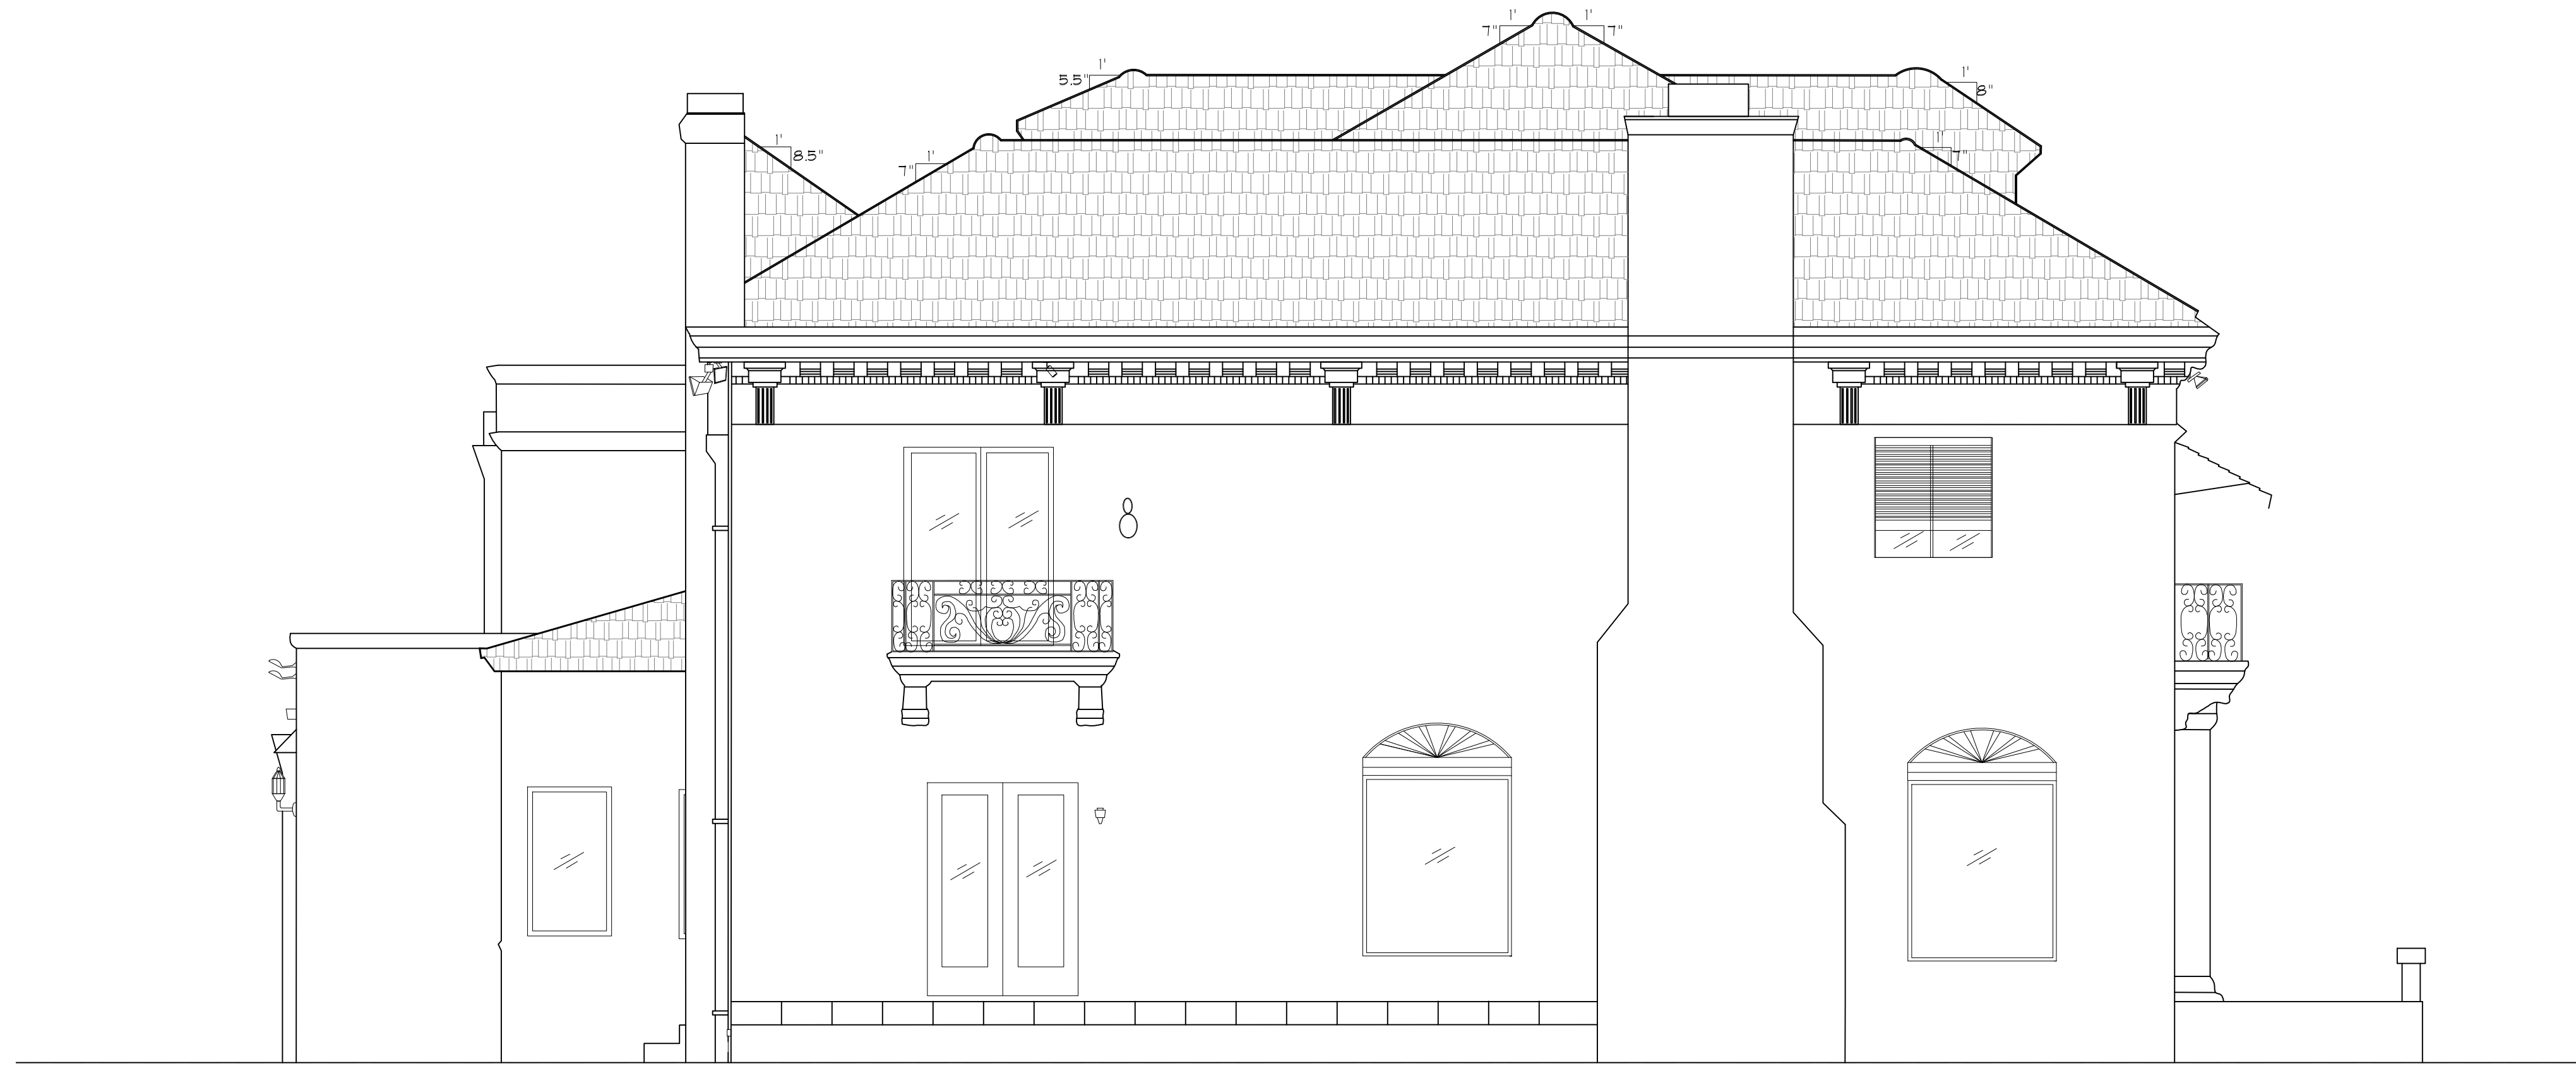

LEFT SIDE ELEVATION



RIGHT SIDE ELEVATION

ARCHITECTURAL AS BUILT
ITALIAN RENAISSANCE RESIDENCE
115 N. Rossmore Ave
Los Angeles, CA 90004

01 100% SUBMISSION SEE COVER SHEET

NO. ISSUES | REVISIONS DATE

SHEET TITLE

SIDE ELEVATIONS

HL PROJECT MANAGER

HL PROJECT DIRECTOR

012518-1 PROJECT NUMBER

1/4"=1'-0" SCALE

CL DRAWN BY



SHEET NUMBER

AB-2



01	100% SUBMISSION	SEE COVER SHEET
NO.	ISSUES REVISIONS	DATE

SHEET TITLE	
BASEMENT FLOOR PLANS	
HL	PROJECT MANAGER
HL	PROJECT DIRECTOR
012518-1	PROJECT NUMBER
1/4"=1'-0"	SCALE
CL	DRAWN BY
SHEET NUMBER	

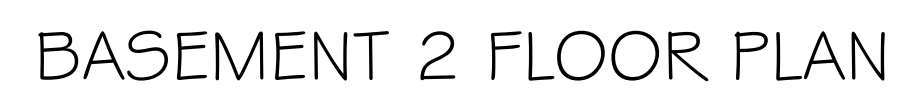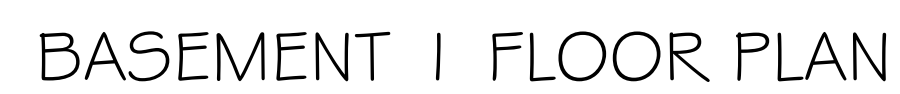



**ARCHITECTURAL AS BUILT
ITALIAN RENAISSANCE RESIDENCE**

**115 N. Rossmore Ave
Los Angeles, CA 90004**



AB-4



AB-5

SECOND FLOOR PLAN (RESIDENCE)

[illegible]

SHEET TITLE

SHEET TITLE

HL	PROJECT MANAGER
----	-----------------

HL	PROJECT DIRECTOR
----	------------------

012518-1	PROJECT NUMBER
----------	----------------

3/8"=1'-0" SCALE


C1	DRAWN BY
----	----------

SHEET NUMBER

Table 1. Demographic characteristics of study population



ATTIC FLOOR PLAN (RESIDENCE)

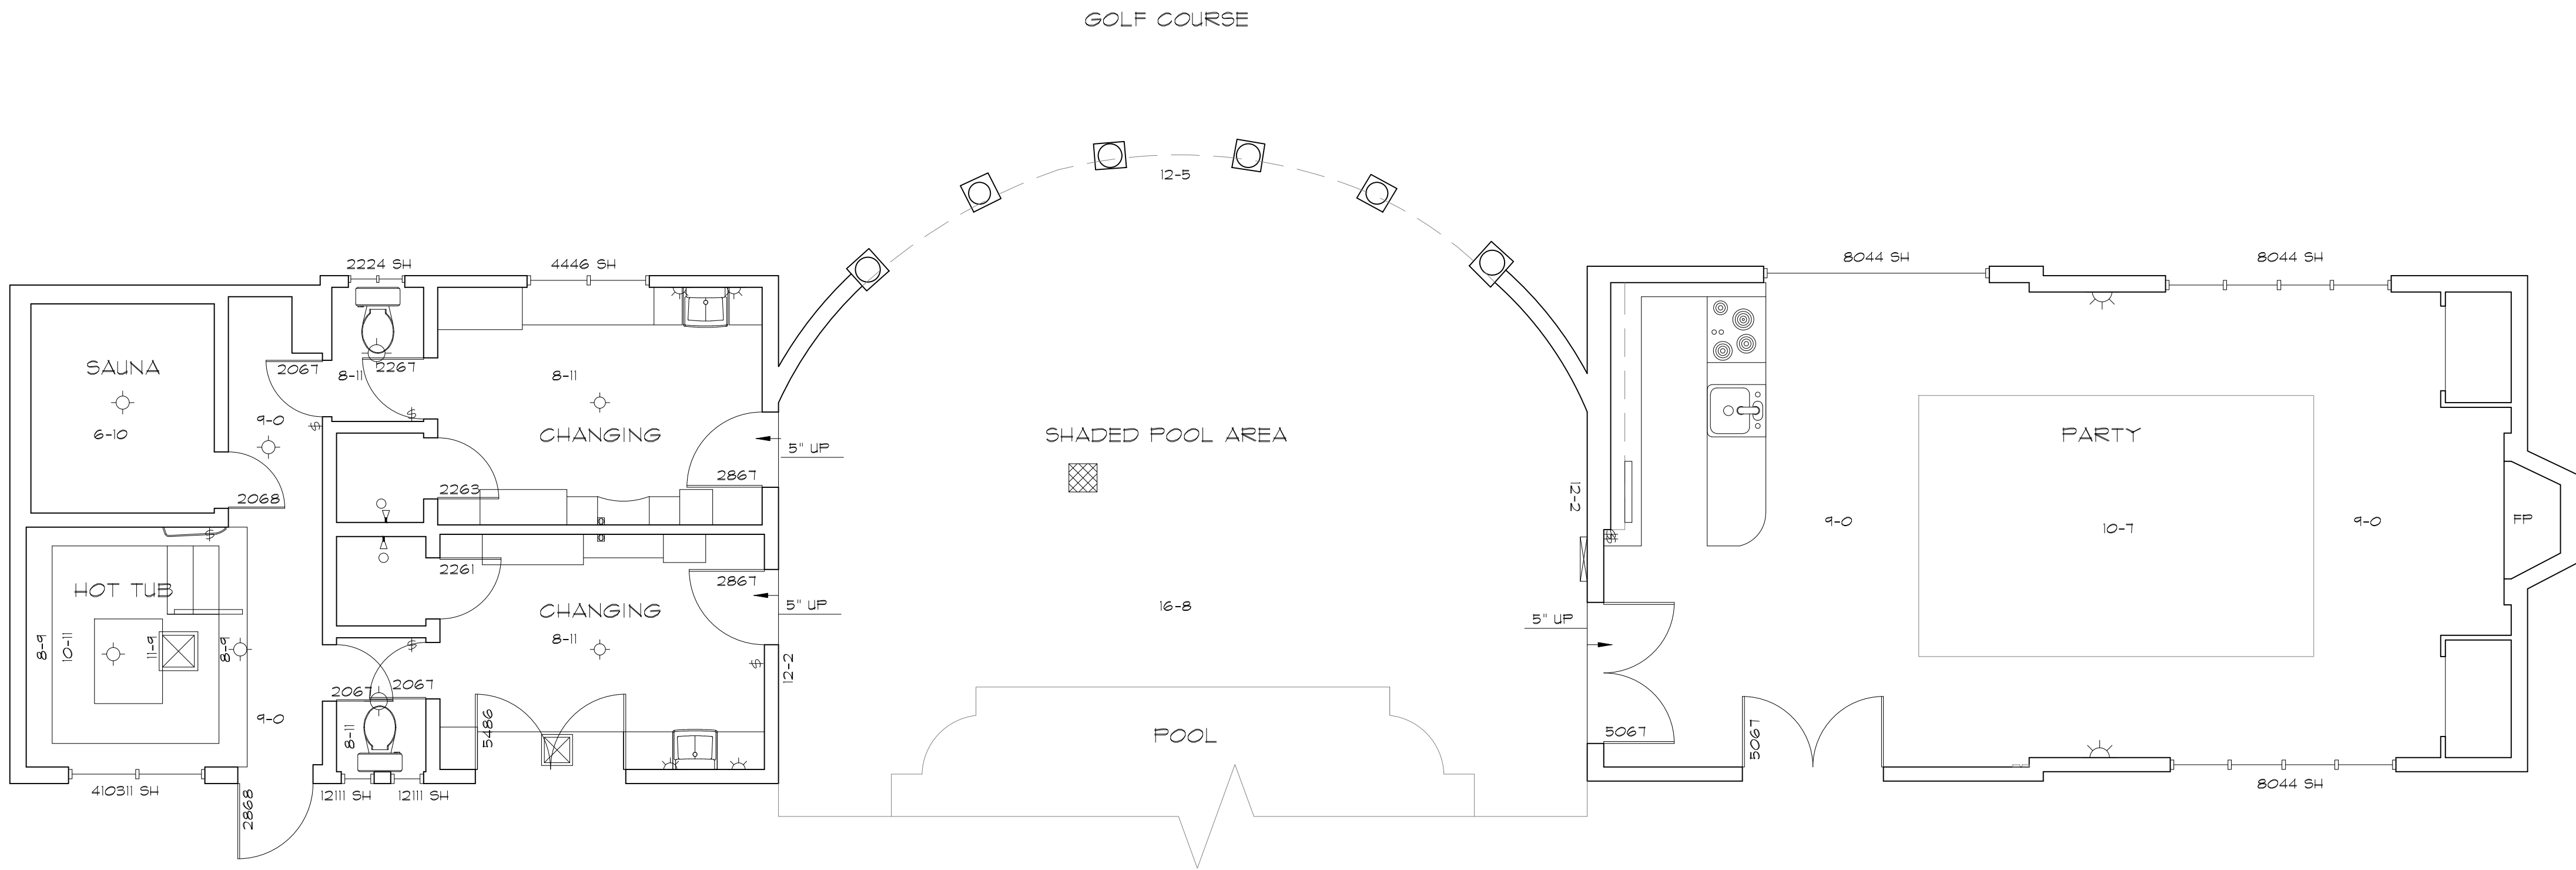

CABANA FLOOR PLAN

As BUILT

PROFESSIONALS

www.asbuiltprofessionals.com

A DIVISION OF:

AEC

CONSULTANTS INC

844.272.8458

844 ASBUILT

© 2018 AEC CONSULTANTS INC

ARCHITECTURAL AS BUILT
ITALIAN RENAISSANCE RESIDENCE
115 N. Rossmore Ave
Los Angeles, CA 90004


01	100% SUBMISSION	SEE COVER SHEET
NO.	ISSUES REVISIONS	DATE
SHEET TITLE		
CABANA FLOOR PLAN		
HL	PROJECT MANAGER	
HL	PROJECT DIRECTOR	
012518-1	PROJECT NUMBER	
1/4"=1'-0"	SCALE	
CL	DRAWN BY	
SHEET NUMBER		
AB-7		



01	100% SUBMISSION	SEE COVER SHEET
NO.	ISSUES REVISIONS	DATE
		SHEET TITLE
GARAGE FIRST FLOOR		
HL	PROJECT MANAGER	
HL	PROJECT DIRECTOR	
012518-1	PROJECT NUMBER	
3/8"=1'-0"		SCALE
CL	DRAWN BY	
		SHEET NUMBER
AB-8		



**115 N. Rossmore Ave
Los Angeles, CA 90004**

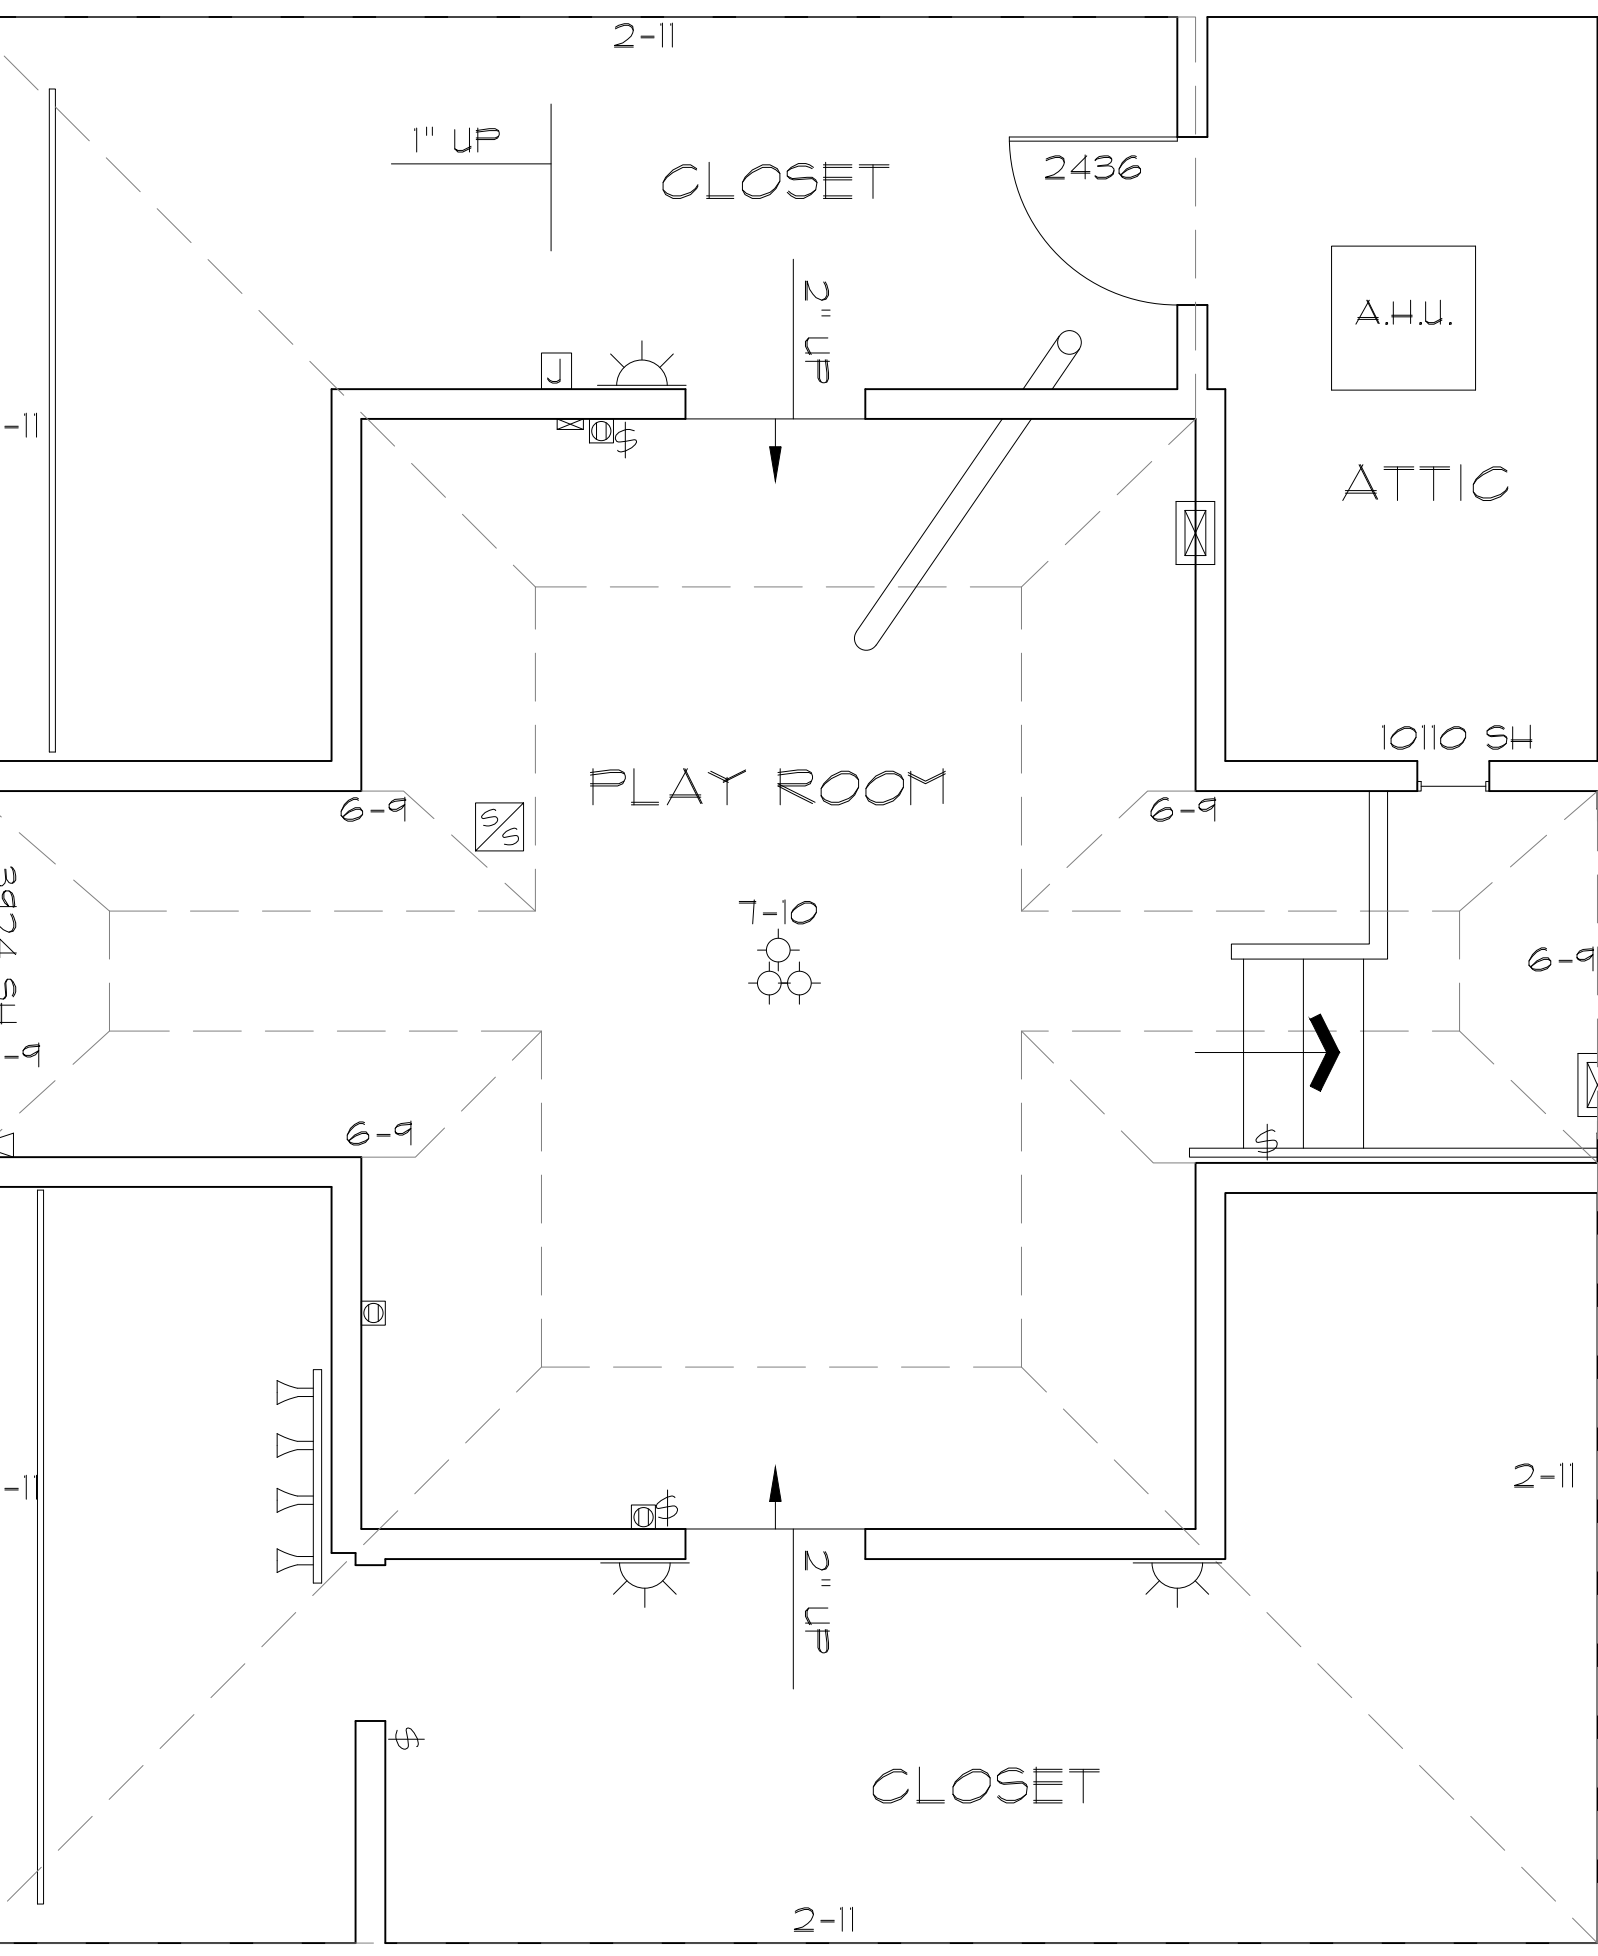


GARAGE SECOND FLOOR PLAN

01	100% SUBMISSION	SEE COVER SHEET
NO.	ISSUES REVISIONS	DATE
		SHEET TITLE
GARAGE SECOND FLOOR		
HL	PROJECT MANAGER	
HL	PROJECT DIRECTOR	
012518-1	PROJECT NUMBER	
3/8"=1'-0"	SCALE	
CL	DRAWN BY	
		SHEET NUMBER
AB-9		



© 2018 AEC CONSULTANTS INC

**ARCHITECTURAL AS BUILT
ITALIAN RENAISSANCE RESIDENCE
115 N. Rossmore Ave
Los Angeles, CA 90004**

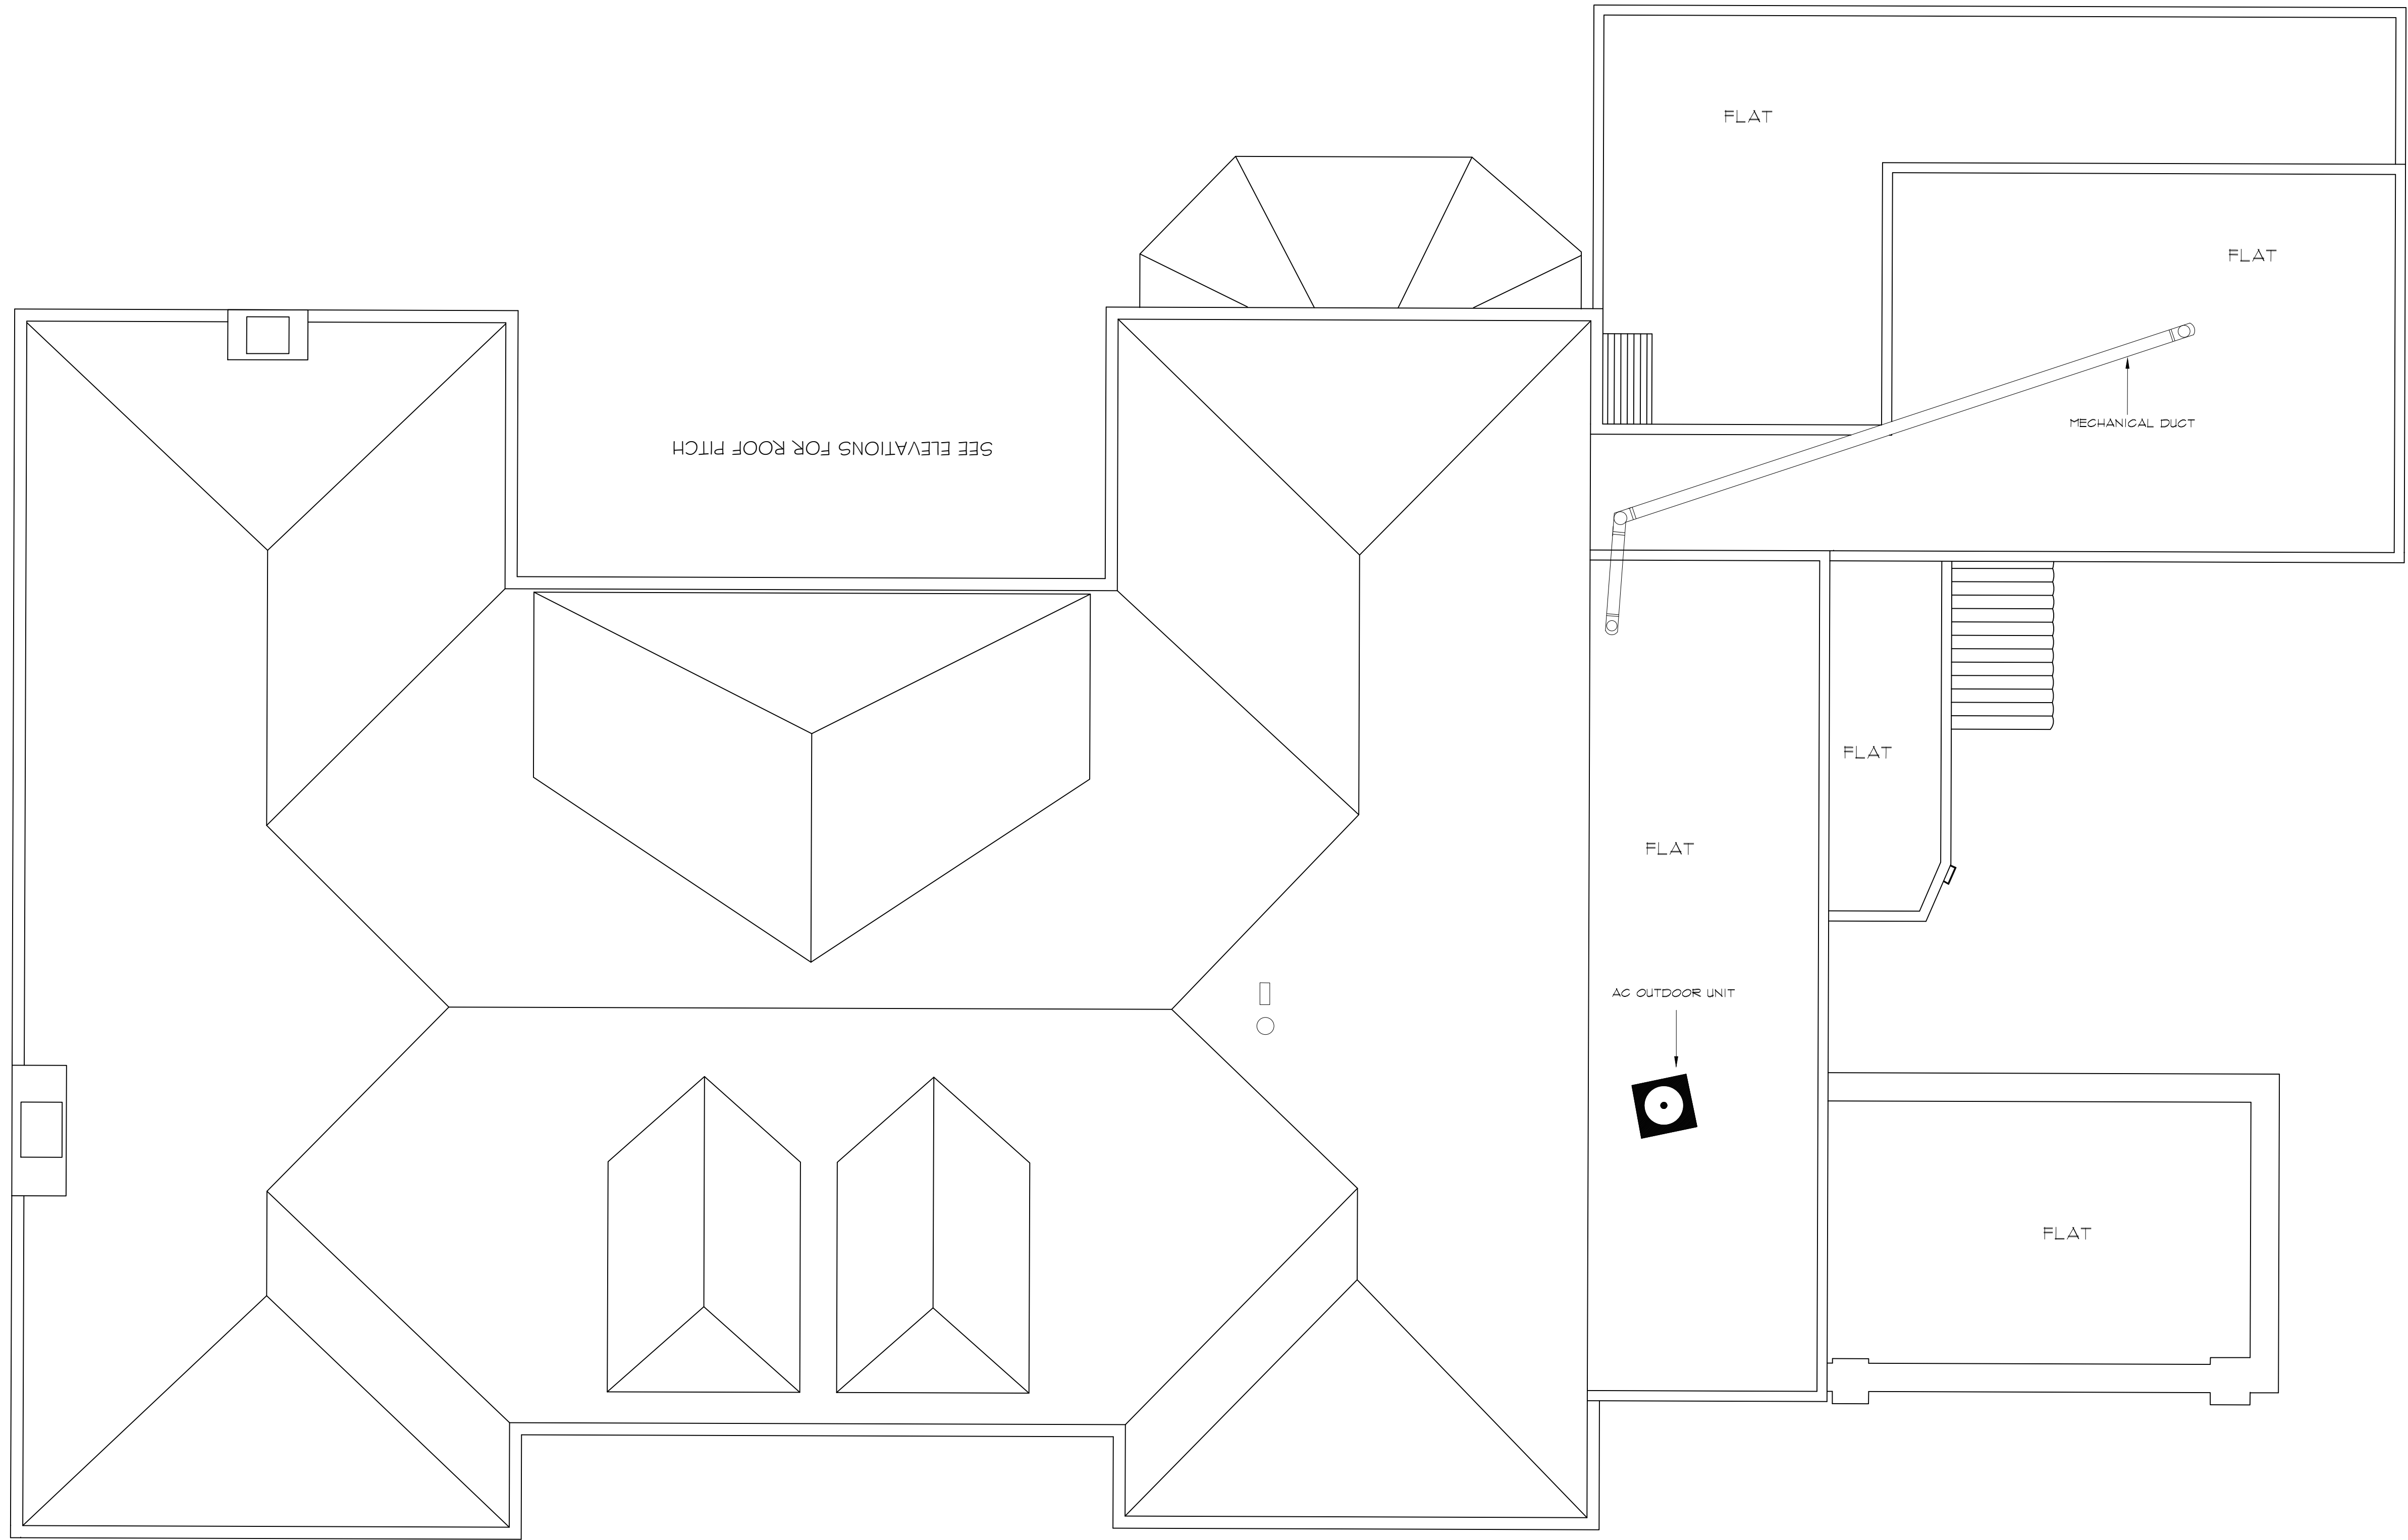

ROOF PLAN

01	100% SUBMISSION	SEE COVER SHEET
NO.	ISSUES REVISIONS	DATE
		SHEET TITLE
ROOF PLAN		
HL		PROJECT MANAGER
HL		PROJECT DIRECTOR
012518-1		PROJECT NUMBER
1/4"=1'-0"		SCALE
CL		DRAWN BY
		SHEET NUMBER

ROOF PLAN

HL PROJECT MANAGER

HL PROJECT DIRECTOR

012518-1	PROJECT NUMBER
----------	----------------

1/4"=1'-0" SCALE

CL DRAWN BY

SHEET NUMBER

AB-10